

MISSISSIPPI DEPARTMENT OF NATURAL RESOURCES  
Bureau of Land and Water Resources

Southport Mall  
P.O. Box 10631

Jackson, Mississippi 39209  
WATER WELL DRILLERS LOG

CODED

D 63  
Hancock  
11-20-84

Hancock Co.  
Pearl River

11/20/84  
date well completed

Lyman Well Co.  
firm name

county well located

LANDOWNER: Kendall Hummer, Jr.  
Rt. 1  
Prichard, Ms 39466  
(mailing address)

Description of formations encountered	from	to
yellow clay	0	8
white clay	8	25
blue clay	25	100
fine sand	160	174
blue clay	174	380
good sand	380	440

WELL LOCATION:

sec. 7 T. 6 N. R. 14 E  
10 miles NE of Kiln  
(distance) (direction) (nearest town)

WELL PURPOSE: home  
(home, irrigation, municipal, industrial)

WELL COMPLETION DATA:

- (1) diameter (inches) 4"
- (2) total depth (feet) 438'
- (3) static water level (feet) 60 <sup>below</sup> above top of ground.
- (4) casing PVC 423'  
(material) (depth)
- 4"  
(size) if telescope see back.
- (5) screen 15' 423'  
(length) (depth to top)
- 4" PVC  
(size) (material)
- (6) pump 1 1/2 27  
(HP) (yield gpm)
- electric  
(type power)
- (7) electric log No  
(yes or no)
- No  
(organization running log)
- (8) how well bottom plugged sand  
shark

CODEL

DEPT. OF NATURAL RESOURCES  
BUREAU OF LAND & WATER RESOURCES


DEC 17 1984

RECEIVED

DRILLERS REMARKS:

If well telescopes please sketch and show depths.

GROUND LEVEL

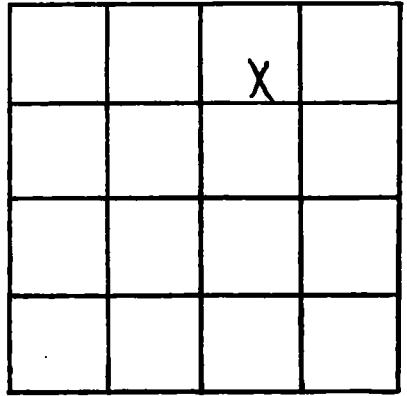

SECTION 1

Please indicate well location X.

ADDITIONAL INFORMATION

If more than one screen, show locations of each on sketch.