

MISSISSIPPI DEPARTMENT OF NATURAL RESOURCES

Bureau of Land and Water Resources

Southport Mall

P.O. Box 10631

CODED

Jackson, Mississippi 39209

WATER WELL DRILLERS LOG

85 POUNCEY WATER WELL DRILLING

Hancock

Hancock
D 65
5-11-85

5-11-1985
date well completed

firm name

county well located

LANDOWNER: Mr. Burkhead

description of formations encountered

from

to

Hy 603

TOP. CODED. 26
pink ss. 26 34
Blue Clay 34 92
Clay 92 208
slt. fine ss. 208 277
Clay 277 378
fine to good. 278 400

(mailing address)

WELL LOCATION:

sec 8 T 6 N R 14 E
(S) (W)
4 1/2 miles S of Nacaire
(distance) (direction) (nearest town)

WELL PURPOSE: Home
(home, irrigation, municipal, industrial)


WELL COMPLETION DATA:

- (1) diameter (inches) 2
- (2) total depth (feet) 400
- (3) static water level (feet) 80 below top of ground
- (4) casing PVC 390
(material) (depth)
- 2 If telescope see back.
(size)
- (5) screen 10 390
(length) (depth to top)
- 2 PVC
(size) (material)
- (6) pump 1 8
(HP) (yield gpm)
- 230 V AC
(type power)
- (7) electric log (yes or no)

(organization running log)

(8) how well bottom plugged sealed.

DRILLERS REMARKS:

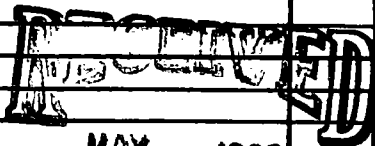

Department of Natural Resources
Bureau of Land & Water Resources

If well telescopes please sketch and show depths.

GROUND LEVEL

SECTION _____

Please indicate well location X.

ADDITIONAL INFORMATION

If more than one screen, show locations of each on sketch.