

MISSISSIPPI DEPARTMENT OF ENVIRONMENTAL QUALITY
Office of Land and Water Resources

P. O. Box 10631
Jackson, MS 39289-0631
WATER WELL DRILLERS LOG

COUNTY WELL LOCATED
Hancock
WELL NAME
D-16
CODES
68
DATE WELL COMPLETED
12/02/03

PERMIT NUMBER
NAME OF DRILLING FIRM
Lynas Well Co.

NAME & MAILING ADDRESS OF LANDOWNER
Standard-Oedeanx
Water Ass. Standard Well
Latitude:
Longitude: 303108N/892109W
WELL LOCATION SEC TOWNSHIP RANGE
24 6 N 14 W
DISTANCE DIRECTION NEAREST TOWN
1/2 mile N - Pass chair
OTHER LANDMARK
WELL PURPOSE: Home, Irrigation, Municipal, Industrial, Fish Pond, etc.

WELL DATA
Well Depth 1375 Casing Diameter (in.) 12" Casing Length (ft.) 1290
Type of Casing Steel Hole Depth 1380 Depth to Static Water Level 102
TYPE OF COMPLETION: (Circle One or More):
 Gravel Pack Underreamed Telescoped
 Natural Development Open Hole Other
WELL GROUTED TO A DEPTH OF 1290 FEET
Type Grout (circle one): Cement, Bentonite, or Mix

SCREEN DATA
Diameter - inches 5 1/2 Length - Feet 87 Slot Size - inches .12
Screen Type SS Depth to Screen - Feet 1375

PUMP DATA
PUMP TYPE (Circle One):
Submersible Turbines Jet Flowing Well, Other (Describe) _____
POWER TYPE (Circle One):
Electric Tractor Diesel Gasoline Battery Other (Describe) M/P
DESCRIPTION OF FORMATIONS ENCOUNTERED FROM TO
Red sand & gravel 0 180
yellowish clay 180 350
medium sand 350 618
blue clay 618 780
fine sand 780 830
blue clay 830 1040
sand 1040 1140
blue clay 1140 1165
fine sand 1165 1220
blue clay 1220 1245
fine sand 1245 1290
coarse sand 1290 1385
RECEIVED
JUL 28 2004
BY: OLWR
Top of Lap Pipe or Reduction in Casing
1210' FEET IF TELESCOPED OR MORE THAN ONE SCREEN, USE BACK PAGE


I certify that the well was drilled, constructed and completed in accordance with all applicable Requirements of the Mississippi Department of Environmental Quality and/or the Mississippi Department of Health regulations and state laws.
John Sadner 0-640
Signature of Licensed Driller and License No. 12/02/03
Date
Additional Information Required On Back

RECEIVED

JUL 28 2004

BY: OLWR

If well telescopes please sketch and show depths.

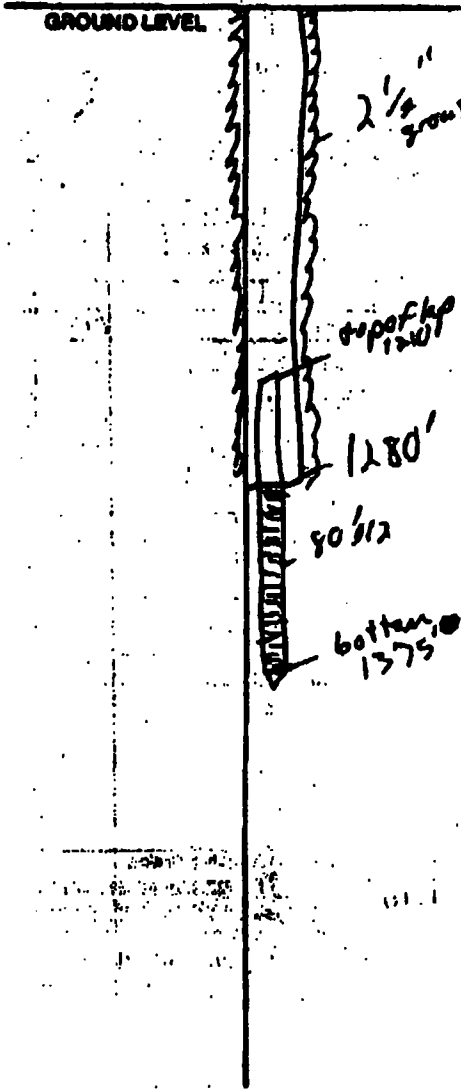

SECTION _____

Please indicate well location X.

Pump Capacity (GPM)	No. of Stages	Setting Depth	FT.
PUMP TEST			
Well yielded	800	GPM with	
a drawdown of	9	ft.	
after	30	hours of pumping	

LOG DATA

TYPE OF LOG RUN (Circle One): No Log Run, Resistivity, Gamma Ray, Density, Sonic, Neutron, Other (Describe) _____

Name of Organization Running Log: DEQ

GEOLOGIC DATA (Office Use Only)

Surface Elev.	Geologic Unit	Unit Thickness	Depth to Top
Subs. Elev.	Date	Analysis	Logster Test

Editor's Remarks

If more than one screen, show location of each on sketch.