

MISSISSIPPI DEPARTMENT OF ENVIRONMENTAL QUALITY
Office of Land and Water Resources

P. O. Box 10631
Jackson, MS 39289-0631
WATER WELL DRILLERS LOG

COUNTY WELL LOCATES
Hancock
WELL NUMBER 2 CODED
D-8569
DATE WELL COMPLETED
9/30/03

FURNY NUMBER
NAME OF DRILLING FIRM
L'Amor Well Co.

NAME & MAILING ADDRESS OF LANDOWNER
Standard Bedeaux
Water Assoc. Hole Road Well
Latitude: 30°31'49"N
Longitude: 89°24'54"W
WELL LOCATION: SEC 17 TOWNSHIP 6 RANGE 14 E
DISTANCE 15 MILES DIRECTION N NEAREST TOWN Pass Christian
OTHER LANDMARKS
WELL PURPOSES: Home, Irrigation, Industrial, Farm Pond, etc.

PUMP DATA

PUMP TYPE (Circle One):
Submersible, Turbine, Jet, Flowing Well,
Other (Describe)

POWER TYPE (Circle One):
 Electric, Tractor, Diesel, Gasoline, Sulfate,
Other (Describe) MVP 75

DESCRIPTION OF FORMATIONS ENCOUNTERED	FROM	TO
topsoil / forage	0	60
sand / gravel	60	85
white clay	85	220
sand	220	320
clay	320	380
coarse sand	380	450
clay	450	580
clay	580	670
fine sand	670	820
hard blue clay	820	1120
coarse sand	1120	1338

WELL DATA

Well Depth: 1320 Casing Diameter (in): 12" Casing Length (ft): 1220
Type of Casing: steel Hole Depth: 1322 Depth to Static Water Level: 66'
TYPE OF COMPLETION: (Circle One or More):
 Cemented, Underreamed, Unscreened,
Natural Development, Open Hole, Other
WELL GROUTED TO A DEPTH OF 1220 FEET
Type Grout (circle one): Cement, Bentonite, or Mix

SCREEN DATA

Diameter - inches: 8" Length - Feet: 90' Slot Size - inches: .012
Screen Type: SS wire Depth to Bottom - Feet: 1320

RECEIVED
JUL 28 2004
BY: OLWR
Top of Log Pipe or Reduction in Casing: 1150 FEET
IF FILLED IN ON MORE THAN ONE SCREEN: USE BACK PAGE

I certify that the well was drilled, constructed and completed in accordance with all applicable Requirements of the Mississippi Department of Environmental Quality and/or the Mississippi Department of Health regulations and state laws.

John Johnson 0-640
Signature of Licensed Driller and License No.

9/30/03
Date


Additional Information Required On Back

RECEIVED

JUL 28 2004

BY: OLWR

If well telescopes please sketch and show depth.

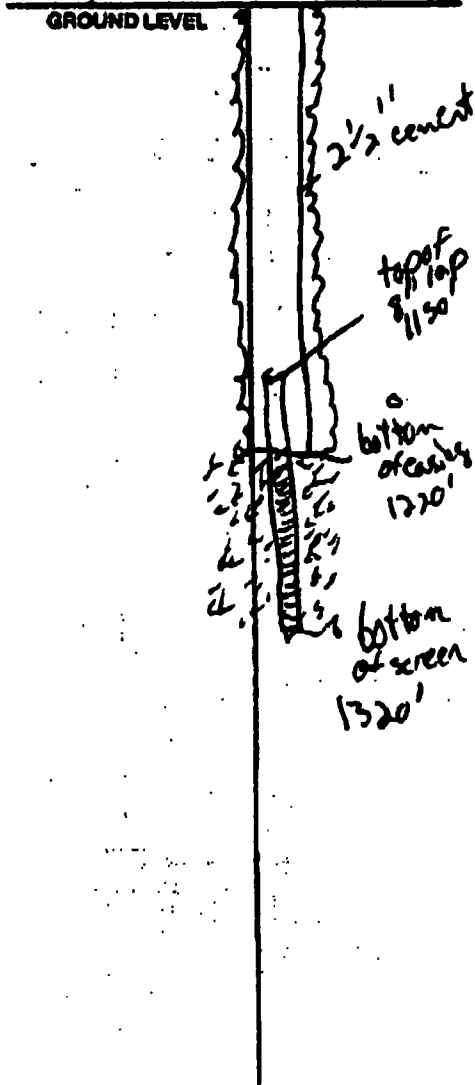

SECTION _____

Please indicate well location X.

Pump Capacity (GPM)	No. of Stages	Screening Depth	FT.
PUMP TEST			
Well yielded	800	GPM with	
a drawdown of	11	ft.	
after	30	hours of pumping	

LOG DATA

TYPE OF LOG RUN (Circle One): No Log Run, Electrical, Gamma Ray, Density, Sonic, Neutron, Other (Describe) _____

Name of Geophysical Logging Log: DEQ

GEOLOGIC DATA (Office Use Only)

Surface Elev.	Geologic Unit	Unit Thickness	Depth to Top
Sub. Elev.	Date	Analysis	Aquifer Test

Owner's Remarks

If more than one screen, show location of each on sketch.