

HANCOCK MISSISSIPPI BOARD OF WATER COMMISSIONERS

D. 2003

12-24-64

WATER WELL DRILLERS LOG

A

Date: 12-24, 19 64, Driller: Sutter Well Works County Hancock

(Name)

(1) Owner of Land: Herman Ladner
(Name)

Rt 1 Pass Christian
(Address)

(2) Location: NE 1/4, NE 1/4, Sec. 25 T6S R14, W

7 miles NNE of Fenton
(distance) (direction) (Nearest Town)

(3) Topography: Hilly
(Hilly) (Flat) (Level)

(4) Purpose of Well: domestic
(Domestic Irrigation
Municipal, Industrial, Other)

Description & Color of Materials
Sand, Clay, Red Clay, Shell, etc.

Thick-
ness
Feet

Depth
Feet

Old well drilled
deeper from 423' to
508'
all sand

Information upon completion of well:

(1) Diameter 2 inches.

(2) Total Depth 508 feet.

(3) Water Level 56 feet below top of ground.

(4) Cased to all, Size 2"

(5) Screen: Size 2", Length 10'


(6) Were any formations sealed against pollution?

no yes, no.

If YES depth of formation _____

Why _____

Drillers Remarks: _____

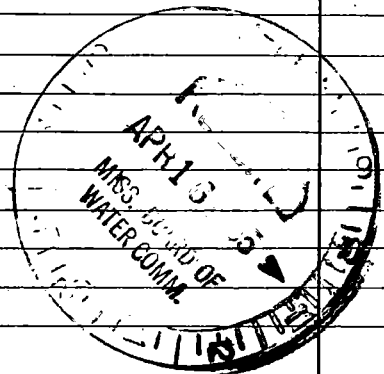

(Use Back Side)

Well No.

