

D 2005
5-25-66

WATER WELL DRILLERS LOG

Date: May 25, 1966, Driller: L Beech County Hancock
(Name)

(1) Owner of Land: W O Thornton
(Name)

A.T. 1 Box 458 Doy St
(Address)

(2) Location: SE 1/4, NE 1/4, Sec. 31 T 6 R 14
5 miles north of Kiln
(distance) (direction) (Nearest Town)

(3) Topography: X (Hilly) (Flat) (Level)

(4) Purpose of Well: Hand
(Domestic Irrigation
Municipal, Industrial, Other)

Description & Color of Materials Sand, Clay, Red Clay, Shell, etc.	Thick- ness Feet	Depth Feet
soft mud	40	40
sand	65	105
Black mud	21	126
sand strata	42	168

Information upon completion of well:

(1) Diameter 2 1/4 inches.

(2) Total Depth 168 feet.

(3) Water Level 10 feet below top of ground.

(4) Cased to _____, Size _____.


(5) Screen: Size 1 1/4, Length 15.

(6) Were any formations sealed against pollution?
_____ yes, _____ no.

If YES depth of formation _____.

Why _____.

Drillers Remarks: _____.

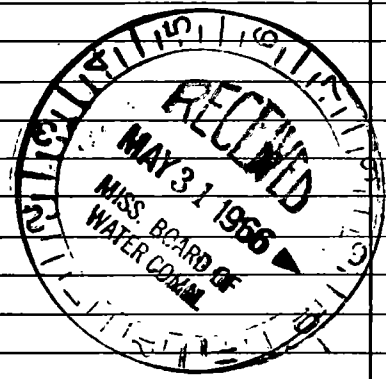

(Use Back Side)

Well No.

