

Hancock
D 9007
12-67

MISSISSIPPI
 BOARD OF WATER COMMISSIONERS
 416 North State Street
 Jackson, Mississippi 39201

WATER WELL DRILLERS LOG

12-8 1967 Sutter Well Works Hancock
 date well completed firm name county well located

LANDOWNER: E.D. Melley
Rt 1 Box 226 A
Pass Christian, Miss.
 (mailing address)

description of formations encountered	from	to
	<u>sand</u>	<u>0</u>
<u>clay - small sand str.</u>	<u>30</u>	<u>338</u>
<u>sand</u>	<u>338</u>	<u>379</u>


WELL LOCATION:
 sec. 24 T. 6 S. R. 14 W.
1/2 miles W of Vidalia
 (distance) (direction) (nearest town)

WELL PURPOSE: home
 (home, irrigation, municipal, industrial)

WELL COMPLETION DATA:

- (1) diameter (inches) 2
- (2) total depth (feet) 379
- (3) static water level (feet) 96 below top of ground.
- (4) casing galv. 369'
 (material) (depth)
2"
 (size) if telescope see back.
- (5) screen 10' 369'
 (length) (depth to top)
2" stainless steel
 (size) (material)
- (6) pump 1 6
 (HP) (yield gpm)
elec
 (type power)
- (7) electric log No
 (yes or no)
 (organization running log)
- (8) how well bottom plugged BPU valve

DRILLERS REMARKS:

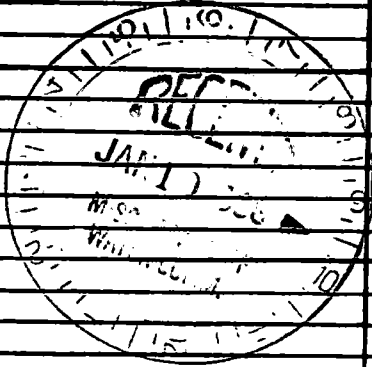

If well telescopes please sketch and show depths.

GROUND LEVEL

		X	

SECTION 24

Please indicate well location X.

ADDITIONAL INFORMATION

If more than one screen, show locations of each on sketch.