

**MISSISSIPPI
BOARD OF WATER COMMISSIONERS**
416 North State Street
Jackson, Mississippi 39201

WATER WELL DRILLERS LOG

HANCOCK
D 2008
2-68

Feb. 20 1968 M&B Drilling Co. Hancock
date well completed firm name county well located

LANDOWNER: F.H. Tribble
Bt 1 Box 224
Pass Christian, Miss.
(mailing address)


WELL LOCATION:
sec. 24 T. 6 S. R. 14 W.
1 miles N. of DeLoach
(distance) (direction) (nearest town)

WELL PURPOSE: Home Farm
(home, irrigation, municipal, industrial)

WELL COMPLETION DATA:

- (1) diameter (inches) 2
- (2) total depth (feet) 390
- (3) static water level (feet) 110 below top of ground.
- (4) casing Galv. Steel 380 (material) (depth)
2" (size) If telescope see back.
- (5) screen 5 325 (length) (depth to top)
2" Stainless Steel .010 (size) (material)
- (6) pump 1-2 1/2 hp Jet 6 (HP) (yield gpm)
220 Volt 10 (type power)
- (7) electric log No (yes or no)
(organization running log)
- (8) how well bottom plugged 2" Buck Wash Pipe

description of formations encountered	from	to
Surface Clay	0	15
Sandy Clay	15	25
White Sand	25	30
Yellow sand & Coarse		
Brown Gravel to 3/4" diam.	30	110
White Clay	110	150
White Sand	150	155
White Clay	155	175
Blue Clay	175	215
Sand	215	217
Blue Clay	217	240
White Clay	240	245
White Sand	245	270
Blue Clay	270	325
Fine Grey Sand	325	340
Clay & Sand Breeds	340	355
Grey Sand - Good	355	390
Still cutting sand when drilling stopped.		
Crack tough to drill thru		
3 Sacks Quick Gel & 3 hours		
<u>J.R.B.</u>		

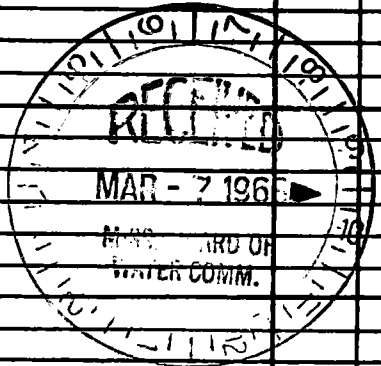

DRILLERS REMARKS:

