

Hancock
D 2012
6-3-75

MISSISSIPPI
 BOARD OF WATER COMMISSIONERS
 416 North State Street
 Jackson, Mississippi 39201

WATER WELL DRILLERS LOG


June 3 1975 S&S well works Hancock
 date well completed firm name county well located

LANDOWNER: <u>Carmel Jones</u>	description of formations encountered	from	to
<u>Pl: 1, Passapatan</u> <u>Miss -</u> (mailing address)	<u>top soil</u> <u>Clay</u> <u>Sand</u>	<u>0</u> <u>2</u> <u>32</u>	<u>2</u> <u>32</u> <u>33</u>
WELL LOCATION:			
sec. <u>5</u> T. <u>6</u> N. R. <u>14</u> E. <u>135</u> <u>Standard</u> <u>Communit</u> (distance) miles (direction) of (nearest town)			
WELL PURPOSE: <u>Home</u> (home, irrigation, municipal, industrial)			
WELL COMPLETION DATA:			
(1) diameter (inches) <u>4</u>			
(2) total depth (feet) <u>9'3"</u>			
(3) static water level (feet) <u>40</u> <u>below</u> above top of ground.			
(4) casing <u>PVC</u> , <u>73</u> , (material) (depth)			
<u>4</u> (size) If telescope see back.			
(5) screen <u>10</u> , <u>73</u> (length) (depth to top)			
<u>4</u> , <u>PVC</u> (size) (material)			
(6) pump <u>2</u> , <u>12</u> (HP) (yield gpm)			
<u>E</u> (type power)			
(7) electric log <u>no</u> (yes or no)			
(organization running log)			
(8) how well bottom plugged <u>BW</u>			
DRILLERS REMARKS: <u>none</u>			

MISS. BD. OF WATER
 JUN 10 1975

If well telescopes please sketch and show depths.

GROUND LEVEL

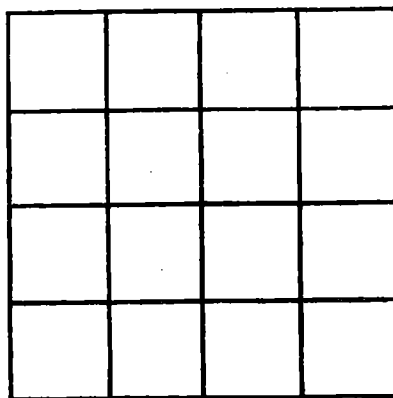

SECTION _____

Please Indicate well location X.

ADDITIONAL INFORMATION

If more than one screen,
show locations of each on sketch.