

Hancock
D 7013
7-7-75

MISSISSIPPI
BOARD OF WATER COMMISSIONERS
416 North State Street
Jackson, Mississippi 39201

WATER WELL DRILLERS LOG

Hancock

July 7 1975 S & S Well Works firm name
date well completed county well located


LANDOWNER: <u>Jack Curran</u>	description of formations encountered	from	to
<u>will find out on sand</u>			
<u>with next water log</u> (mailing address)	<u>TOP Soil</u>	0	3
	<u>Clay</u>	3	50
	<u>Sand</u>	50	62
	<u>Clay</u>	62	128
	<u>Sand</u>	128	159
WELL LOCATION: <u>14</u> sec. <u>11</u> T <u>6</u> N R <u>13</u> E <u>135</u>			
<u>6</u> miles <u>S</u> of <u>Miss. County</u> (distance) (direction) (nearest town)			
WELL PURPOSE: <u>Home</u> (home, irrigation, municipal, industrial)			
WELL COMPLETION DATA:			
(1) diameter (inches) <u>2</u>			
(2) total depth (feet) <u>158</u>			
(3) static water level (feet) <u>74</u> below above top of ground.			
(4) casing <u>PVC</u> , <u>128</u> (material) (depth)			
<u>2</u> (size) If telescope see back.			
(5) screen <u>10</u> , <u>148</u> (length) (depth to top)			
<u>2</u> , <u>PVC</u> (size) (material)			
(6) pump <u>1</u> , <u>6</u> (HP) (yield gpm)			
<u>2</u> (type power)			
(7) electric log <u>no</u> (yes or no)			
(organization running log)			
(8) how well bottom plugged <u>Best</u>			
DRILLERS REMARKS:			
<u>None</u>			

REGISTERED
OCT 30 1975

MISS. BD. OF WATER COMMISSIONERS

If well telescopes please sketch and show depths.

GROUND LEVEL

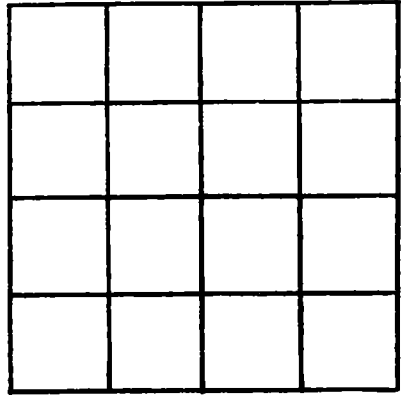

SECTION _____

Please indicate well location X.

ADDITIONAL INFORMATION

A series of horizontal lines for recording additional information, starting below the 'ADDITIONAL INFORMATION' header and extending to the bottom of the page.

If more than one screen, show locations of each on sketch.