

Hancock  
 D 7014  
 9-20-75

MISSISSIPPI  
 BOARD OF WATER COMMISSIONERS  
 416 North State Street  
 Jackson, Mississippi 39201  
 WATER WELL DRILLERS LOG

Sept 20 1975 SLS well works Hancock  
 date well completed firm name county well located


LANDOWNER: John Lader	description of formations encountered	from	to
P2, Bot 296	TOP SOIL	0	3
Pass Christian (mailing address)	Clay	3	18
WELL LOCATION:	Sand	18	53
sec. 25 T 6 N R 14 E 135 3 miles S of Deadwood (distance) (direction) (nearest town)			
WELL PURPOSE: Home (home, irrigation, municipal, industrial)			
WELL COMPLETION DATA:			
(1) diameter (inches) 2			
(2) total depth (feet) 53			
(3) static water level (feet) 31 below top of ground.			
(4) casing P.V.C. 43 (material) (depth)			
2 (size) if telescope see back.			
(5) screen 10 43 (length) (depth to top)			
2 P.V.C. (size) (material)			
(6) pump 1 5 (HP) (yield gpm)			
E (type power)			
(7) electric log NO (yes or no)			
(organization running log)			
(8) how well bottom plugged B.W.			

DRILLERS REMARKS:  
 [Signature]

OCT 30 1975  
 MISS. BD. OF WATER COMMISSIONERS

If well telescopes please sketch and show depths.

GROUND LEVEL

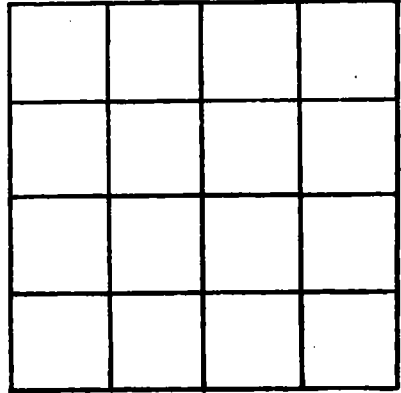

SECTION \_\_\_\_\_

Please indicate well location X.

ADDITIONAL INFORMATION

If more than one screen, show locations of each on sketch.