

Hancock  
D 2015  
10-4-75

MISSISSIPPI  
 BOARD OF WATER COMMISSIONERS  
 416 North State Street  
 Jackson, Mississippi 39201

WATER WELL DRILLERS LOG

10-4 1975 Wood Well Drilling Hancock  
 date well completed. firm name county well located

LANDOWNER: Walter Curran  
Rt. 1, Box 445 A  
Pass Christian, Miss  
 (mailing address)

description of formations encountered	from to	
<u>Top Soil - Clay</u>	<u>0</u>	<u>15</u>
<u>Sandy Clay</u>	<u>15</u>	<u>80</u>
<u>Clay</u>	<u>80</u>	<u>120</u>
<u>SD</u>	<u>120</u>	<u>126</u>
<u>Clay w/ SD</u>	<u>126</u>	<u>182</u>
<u>SD</u>	<u>182</u>	<u>212</u>

WELL LOCATION:  
 sec. 3 T. 6 N. R. 14 E <sup>135</sup>  
14 miles N/E of Bi LN  
 (distance) (direction) (nearest town)

WELL PURPOSE: None  
 (home, irrigation, municipal, industrial)

- WELL COMPLETION DATA:
- (1) diameter (inches) 2"
  - (2) total depth (feet) 212'
  - (3) static water level (feet) 80' <sup>below</sup> <sub>above</sub> top of ground.
  - (4) casing PVC, 202'  
 (material) (depth)  
 (size) If telescope see back.
  - (5) screen 10', -  
 (length) (depth to top)  
2", PVC  
 (size) (material)
  - (6) pump 1, 9  
 (HP) (yield gpm)  
Elec  
 (type power)
  - (7) electric log NO  
 (yes or no)  
N/A  
 (organization running log)
  - (8) how well bottom plugged BWV


DRILLERS REMARKS: N/A

RECEIVED  
 NOV 12 1975

MISS. BD. OF WATER COMMISSIONERS

If well telescopes please sketch and show depths.

GROUND LEVEL

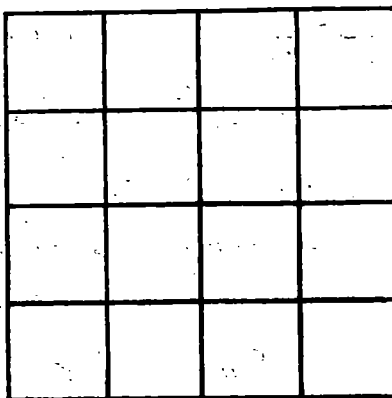

SECTION 3

Please indicate well location X.

ADDITIONAL INFORMATION

If more than one screen, show locations of each on sketch.