

HANCOCK
D 2019
4-25-18

**MISSISSIPPI  
BOARD OF WATER COMMISSIONERS**  
416 North State Street  
Jackson, Mississippi 39201

**WATER WELL DRILLERS LOG**

4-25 date well completed      28 Ward Well Dg. firm name      Hancock county well located

LANDOWNER: Infant of  
Prouse Church -  
Hi-way 603, Pass Christian  
(mailing address)

description of formations encountered	from	to
Top Soil - clay	0	21
SS	21	36
Clay - clay	56	115
SS - g	115	137
Clay - Blue	137	220
SS - coarse	220	252

WELL LOCATION:  
sec. 32 T 6 N R. 14 E  
20 miles N of B.S.L.  
(distance) (direction) (nearest town)

WELL PURPOSE: Home - Church  
(home, irrigation, municipal, industrial)

WELL COMPLETION DATA:

(1) diameter (inches) 4"

(2) total depth (feet) 252'

(3) static water level (feet) 50 <sup>below</sup> top of ground

(4) casing Galv. 232  
(material) (depth)

- If telescope see back.  
(size)

(5) screen 20' -  
(length) (depth to top)

4" Stainless Steel  
(size) (material)

(6) pump 1 1/2 30  
(HP) (yield gpm)

Elec.  
(type power)

(7) electric log no  
(yes or no)

N/A  
(organization running log)

(8) how well bottom plugged BWU

DRILLERS REMARKS: N/A


**RECEIVED**

JUN - 7 1978

MISS. BD. OF WATER COMM.

If well telescopes please sketch and show depths.

GROUND LEVEL

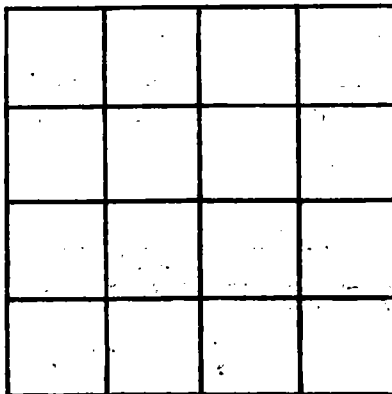

SECTION 32

Please indicate well location X.

ADDITIONAL INFORMATION

A series of horizontal lines for recording additional information.

If more than one screen, show locations of each on sketch.