

HANCOCK

D 2090

9-9-78

MISSISSIPPI
BOARD OF WATER COMMISSIONERS
416 North State Street
Jackson, Mississippi 39201

WATER WELL DRILLERS LOG

Sept 9
date well completed

1978 Mc Gill well works
firm name Inc.

Hancock
Harrison
county well located

LANDOWNER: John Banks

P.O. Box 442

Kilm

(mailing address)

WELL LOCATION:

sec. 31 T. 6 N. R. 14 E.
4 miles N of Kilm
(distance) (direction) (nearest town)

WELL PURPOSE: home
(home, irrigation, municipal, industrial)

WELL COMPLETION DATA:

(1) diameter (inches) 2"
(2) total depth (feet) 480'
(3) static water level (feet) 32' below
top of ground.

(4) casing 5ch. 40 470'
(material) (depth)

— If telescope see back.
(size)

(5) screen 10' —
(length) (depth to top)

2" plastic
(size) (material)

(6) pump 1 14
(HP) (yield gpm)

electric
(type power)

(7) electric log no
(yes or no)

(organization running log)

(8) how well bottom plugged good hard

DRILLERS REMARKS:

description of formations encountered

from

to


mud	0	20
sand	20	80
sand mud	80	120
mud	120	180
sand	180	200
mud - sand	200	220
mud - sand	220	280
mud	280	340
mud sand	340	380
mud	380	400
sand	400	480

RECEIVED
NOV 28 1978

MISS. BD. OF WATER COMMISSIONERS

If well telescopes please
sketch and show depths.

GROUND LEVEL

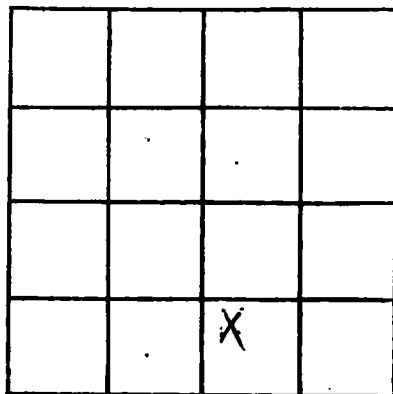

SECTION 31

Please indicate well location X.

ADDITIONAL INFORMATION

If more than one screen,
show locations of each on sketch.