

HANCOCK
 D 7024
 11-22-78

MISSISSIPPI
 BOARD OF WATER COMMISSIONERS
 416 North State Street
 Jackson, Mississippi 39201

WATER WELL DRILLERS LOG


11-22-1978 Ward Well Drilling Hancock
 date well completed firm name county well located

LANDOWNER: <u>Earl Sigera</u>	description of formations encountered	from	to
<u>rt. 3, Box 3149</u>			
<u>Picoyone, missi</u>	<u>sd</u>	<u>81</u>	<u>97</u>
(mailing address)	<u>clay</u>	<u>97</u>	<u>162</u>
	<u>sd</u>	<u>162</u>	<u>198</u>
WELL LOCATION:			
sec. <u>10</u> T. <u>6</u> N. R. <u>14</u> E.			
<u>15</u> miles <u>NW</u> of <u>Kilm</u>			
(distance) (direction) (nearest town)			
WELL PURPOSE: <u>Home</u>			
(home, irrigation, municipal, industrial)			
WELL COMPLETION DATA:			
(1) diameter (inches) <u>2"</u>			
(2) total depth (feet) <u>193</u>			
(3) static water level (feet) <u>30</u> <u>below</u> top of ground.			
(4) casing <u>PVC</u> , <u>183</u> , (material) (depth)			
<u> </u> if telescope see back. (size)			
(5) screen <u>10ft.</u> , <u> </u> (length) (depth to top)			
<u>2"</u> , <u>PVC</u> (size) (material)			
(6) pump <u>owner</u> (HP) (yield gpm)			
<u> </u> (type power)			
(7) electric log <u>no</u> (yes or no)			
<u>NA</u> (organization running log)			
(8) how well bottom plugged <u>BWV</u>			
DRILLERS REMARKS:			

RECEIVED
 DEC 21 1978

If well telescopes please sketch and show depths.

GROUND LEVEL

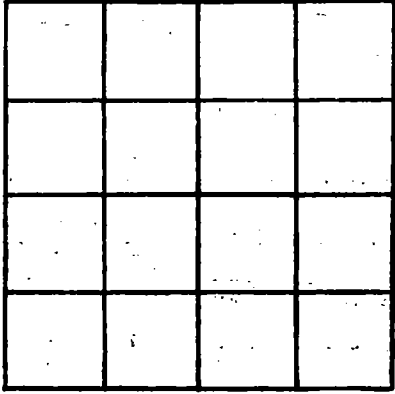

SECTION 10

Please indicate well location X.

ADDITIONAL INFORMATION

Horizontal lines for entering additional information:

If more than one screen, show locations of each on sketch.