

**MISSISSIPPI DEPARTMENT OF NATURAL RESOURCES**  
**Bureau of Land and Water Resources**  
 Southport Mall  
 P.O. Box 10631  
 Jackson, Mississippi 39209  
**WATER WELL DRILLERS LOG**

HANCOCK  
D 2028  
11-24-80

11-24- 1980 WARD WELL DRG. HANCOCK  
 date well completed firm name county well located

LANDOWNER HERBERT DEBUYS  
R.T. 2, BOX 329  
PASS CHRISTIAN, MS.  
 (mailing address)

WELL LOCATION:  
 sec. 25 T. 6 N. R. 184  
70 miles N/E of BILL  
 (distance) (direction) (nearest town)

description of formations encountered	from	to
TOP Clay	0	10
Sand	10	21
<del>Clay</del>	21	110
<del>Clay</del>	110	135
<del>Clay</del>	135	260
Coarse sand	260	299

WELL PURPOSE: NONE  
 (home, irrigation, municipal, industrial)

WELL COMPLETION DATA:

(1) diameter (inches) 2"

(2) total depth (feet) 299

(3) static water level (feet) 5.0 below above top of ground.

(4) casing PVC 289  
 (material) (depth)  
— if telescope see back.  
 (size)

(5) screen 10' —  
 (length) (depth to top)  
2" PVC  
 (size) (material)

(6) pump Ormes —  
 (HP) (yield gpm)  
—  
 (type power)

(7) electric log NO.  
 (yes or no)  
N/A  
 (organization running log)


(8) how well bottom plugged BWU

DRILLERS REMARKS: WELL IS LOCATED IN HANCOCK CO.

DEPT. OF NATURAL RESOURCES  
 BUREAU OF LAND & WATER RESOURCES  
**RECEIVED**  
 DEC 15 1980

If well telescopes please sketch and show depths.

GROUND LEVEL

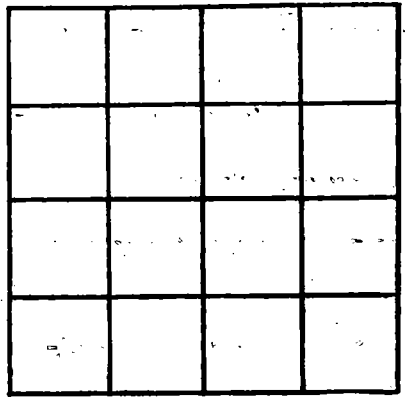

SECTION 25

Please indicate well location X.

ADDITIONAL INFORMATION

If more than one screen, show locations of each on sketch.