

MISSISSIPPI DEPARTMENT OF NATURAL RESOURCES
Bureau of Land and Water Resources
 Southport Mall
 P.O. Box 10631
 Jackson, Mississippi 39209
WATER WELL DRILLERS LOG

HANCOCK
D 2029
11-25-80

11-25 1980 WARD WELL DLG. HANCOCK
 date well completed firm name county well located

LANDOWNER WINTON LADNER
R.T. 1 BOX 396
PASS CHRISTIAN, MS.
 (mailing address)

description of formations encountered	from	to
top Soil - clay	0	10
sd	10	21
clay	21	110
fine sd	110	135
clay - silt	135	260
coarse sd	260	294

WELL LOCATION:
 sec. 27 T 6 N R. 12 W
7 miles N of KILN
 (distance) (direction) (nearest town)

WELL PURPOSE: HOME
 (home, irrigation, municipal, industrial)

WELL COMPLETION DATA:

(1) diameter (inches) 2"

(2) total depth (feet) 294

(3) static water level (feet) 3.5 ^{below} _{above} top of ground.

(4) casing PVC 284
 (material) (depth)

— If telescope see back.
 (size)

(5) screen 10' —
 (length) (depth to top)

2" PVC
 (size) (material)

(6) pump none —
 (HP) (yield gpm)

—
 (type power)

(7) electric log NO
 (yes or no)

N/A
 (organization running log)

(8) how well bottom plugged BWV

DRILLERS REMARKS: N/A


DEPT. OF NATURAL RESOURCES
 BUREAU OF LAND & WATER RESOURCES

DEC 15 1980

RECEIVED

If well telescopes please sketch and show depths.

GROUND LEVEL

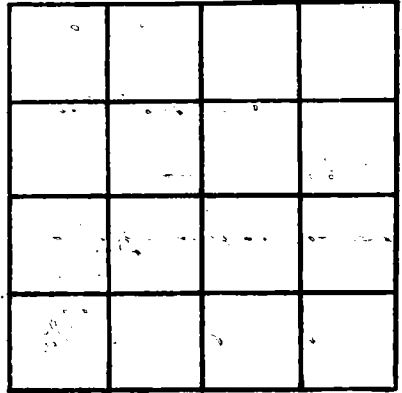

SECTION 22

Please indicate well location X.

ADDITIONAL INFORMATION

If more than one screen,
show locations of each on sketch.