

MISSISSIPPI DEPARTMENT OF NATURAL RESOURCES

Bureau of Land and Water Resources

Southport Mall

P.O. Box 10631

Jackson, Mississippi 39209

WATER WELL DRILLERS LOG

HANCOCK
D 2032
5/18/81

MAY 15 5 1981 NIRO ALLARDNER HANCOCK
date well completed firm name county well located

LANDOWNER: C BOYLE
DEDAUX COMPANY
(mailing address)


description of formations encountered	from	to
<u>BLACKSAIL</u>	<u>0</u>	<u>20</u>
<u>LIGHT CLAY</u>	<u>20</u>	<u>40</u>
<u>BLUE CLAY</u>	<u>40</u>	<u>75</u>

WELL LOCATION: NE 1/4 SW 1/4
sec. 34 T 16 N R 14 E
S W
5 miles SE of DEDAUX
(distance) (direction) (nearest town)

WELL PURPOSE: HOME
(home, irrigation, municipal, industrial)

WELL COMPLETION DATA: MAY 18

- (1) diameter (inches) 2
- (2) total depth (feet) 75
- (3) static water level (feet) FLW below/above top of ground.
- (4) casing PLASTIC, 75
(material) (depth)
- 2c if telescope see back.
(size)
- (5) screen 10, 75
(length) (depth to top)
- 2
(size) (material)
- (6) pump _____
(HP) (yield gpm)
- (type power) _____
- (7) electric log (yes or no) _____
(organization running log) _____
- (8) how well bottom plugged PLASTIC
CAD

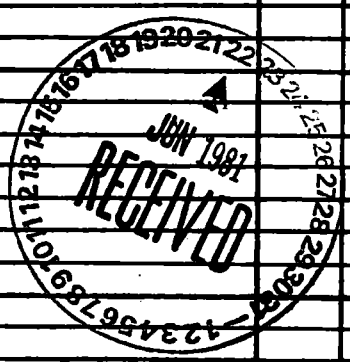

DRILLERS REMARKS: _____

**If well telescopes please
sketch and show depths.**

GROUND LEVEL

SECTION _____

Please indicate well location X.

ADDITIONAL INFORMATION

**If more than one screen,
show locations of each on sketch.**