

MISSISSIPPI DEPARTMENT OF NATURAL RESOURCES

Bureau of Land and Water Resources

Southport Mall

P.O. Box 10631

Jackson, Mississippi 39209

WATER WELL DRILLERS LOG

HANCOCK
D 2033
5/19/81

MAY 19 5 19 81 IRON LADNER HANCOCK
date well completed firm name county well located

LANDOWNER: Billy Dock
Billy Dock Wilson
BEDRUX
(mailing address)

| description of formations encountered | from | to |
|---------------------------------------|-------------------|-----------|
| | <u>BLACK SOIL</u> | <u>0</u> |
| <u>LIGHT CLAY</u> | <u>20</u> | <u>50</u> |
| <u>BONE CLAY</u> | <u>40</u> | <u>75</u> |

WELL LOCATION: NE 1/4 SW 1/4
sec. 24 T. 6 N R. 14 E
LOT NO 2
(distance) miles (direction) of (nearest town)

WELL PURPOSE: EDRUX
(home, irrigation, municipal, industrial)

WELL COMPLETION DATA: MAY 18 5 1981


- (1) diameter (inches) 2
- (2) total depth (feet) 75
- (3) static water level (feet) FLOW below above top of ground.
- (4) casing PLASTIC 75
(material) (depth)
(size) if telescope see back.
- (5) screen 10 FLOW
(length) (depth to top)
(size) (material)
- (6) pump — —
(HP) (yield gpm)
(type power)
- (7) electric log (yes or no) —
(organization running log) —
- (8) how well bottom plugged PLASTIC CAP



DRILLERS REMARKS: —

If well telescopes please sketch and show depths.

GROUND LEVEL

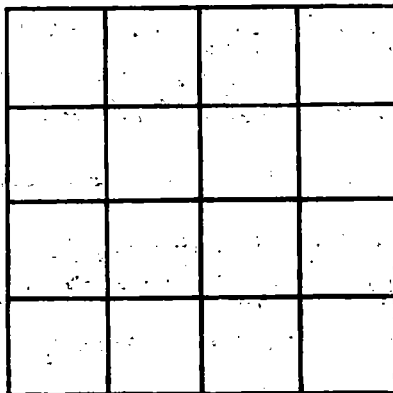

SECTION _____

Please indicate well location X.

ADDITIONAL INFORMATION

If more than one screen, show locations of each on sketch.