

MISSISSIPPI DEPARTMENT OF NATURAL RESOURCES

Bureau of Land and Water Resources

Southport Mall

P.O. Box 10631


Jackson, Mississippi 39209

WATER WELL DRILLERS LOG

HANCOCK
D 2034
5/25/81


MAY 9 1981 date well completed
S. N. IRONLADNER firm name
HANCOCK county well located

LANDOWNER: <u>A. P. PRESSMAN</u>	description of formations encountered	from	to
<u>DEDAUX</u> (mailing address)	<u>Black Soil</u>	0	20
WELL LOCATION: <u>NEL SW 1/4</u> sec. <u>34 T. 6 N R. 14 E 1/4</u> <u>LOT 2</u> miles <u>3</u> of <u>Stamps</u> (distance) (direction) (nearest town)	<u>LIGHT PLAYS</u>	26	40
WELL PURPOSE: (home, irrigation, municipal, industrial)	<u>BLUE CLAY</u>	40	78
WELL COMPLETION DATA: (1) diameter (inches) <u>9</u> (2) total depth (feet) <u>78</u> (3) static water level (feet) <u>1</u> <u>below</u> <u>above</u> top of ground. (4) casing <u>PLASTIC 78</u> (material) (depth) <u>2</u> If telescope see back. (size) (5) screen <u>10</u> <u>1 FOOT</u> (length) (depth to top) (size) (material) (6) pump _____ (HP) (yield gpm) (type power) (7) electric log _____ (yes or no) (organization running log) (8) how well bottom plugged <u>PLASTIC</u> <u>CMP</u>			
DRILLERS REMARKS:			

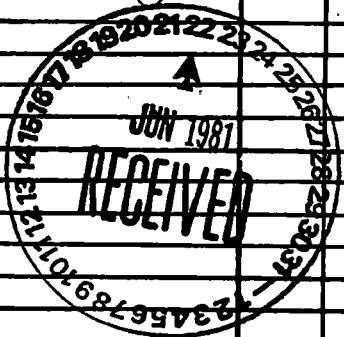

If well telescopes please sketch and show depths.

GROUND LEVEL

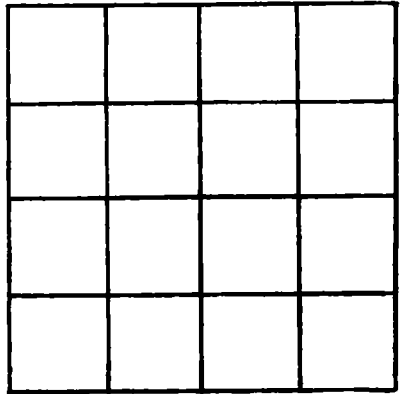

SECTION _____

Please indicate well location X.

ADDITIONAL INFORMATION

If more than one screen,
show locations of each on sketch.