

MISSISSIPPI DEPARTMENT OF NATURAL RESOURCES

Bureau of Land and Water Resources

Southport Mall

P.O. Box 10631

Jackson, Mississippi 39209

WATER WELL DRILLERS LOG

COASTAL DRILLING & SERVICE CO.

Hancock
D2035
6-5-81

6/5/81
date well completed

ROUTE # 618
BOX 618

Hancock
county well located

LANDOWNER	description of formations encountered	from	to
Smith, Bruce	top soil	1	3
Lebeaux, C. Jr.	Red Clay	3	15
Rt 6 from Christian	Coarse white sand	15	65
(mailing address)	Gravel	65	80
	Medium Sand	80	110
	Soft Blue Clay	110	240
	Hard Blue Clay	240	385
	Fine white sand	385	380
	5th white sand	380	400

WELL LOCATION:
sec 24 T 6 N R 14 E S W
(2 1/2 miles SE of Stardand)
(distance) (direction) (nearest town)

WELL PURPOSE: home
(home, irrigation, municipal, industrial)

- WELL COMPLETION DATA:
- (1) diameter (inches) 2"
 - (2) total depth (feet) 400'
 - (3) static water level (feet) 104' below top of ground
 - (4) casing PVC 390' (material) (depth)
 - (5) screen 10' 390' (length) (depth to top)
2" PVC (size) (material)
 - (6) pump 2 hp 7 (HP) (yield gpm)
E/C (type power)
 - (7) electric log (yes or no) (organization running log)

DEPT. OF NATURAL RESOURCES
BUREAU OF LAND & WATER RESOURCES


JUL 22 1981

RECEIVED

(8) how well bottom plugged
2' back with gravel
DRILLERS REMARKS: 19-8

If well telescopes please sketch and show depths.

GROUND LEVEL

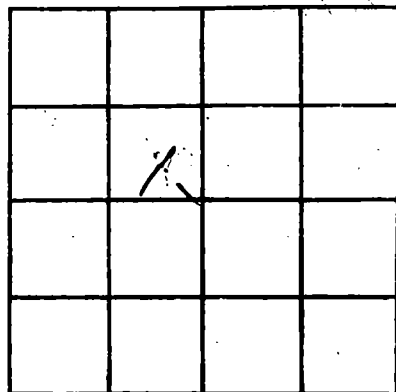

SECTION _____

Please indicate well location X.

ADDITIONAL INFORMATION

If more than one screen, show locations of each on sketch.