

MISSISSIPPI DEPARTMENT OF NATURAL RESOURCES

Bureau of Land and Water Resources

Southport Mall

P.O. Box 10631

Jackson, Mississippi 39209

WATER WELL DRILLERS LOG
COASTAL DRILLING & SERVICE CO.

ROUTE 1 BOX 618

firm name

BILOXI MISS. 39532

county well located

D 2040
1/4/82
date well completed

LANDOWNER

W.S. Horcock

P.O. Box 207

Benton, Miss
(mailing address)

description of formations encountered

from

to

<u>top soil</u>	<u>1</u>	<u>3</u>
<u>red clay</u>	<u>3</u>	<u>15</u>
<u>white sand</u>	<u>15</u>	<u>30</u>
<u>green sand</u>	<u>30</u>	<u>40</u>
<u>soft blue clay</u>	<u>40</u>	<u>200</u>
<u>fine water sand</u>	<u>200</u>	<u>205</u>
<u>hard blue clay</u>	<u>205</u>	<u>300</u>
<u>good water sand</u>	<u>300</u>	<u>320</u>

WELL LOCATION:

sec. 31 T. 6 N. R. 14 E. S. 5 W.
Orphan Creek
(distance) miles (direction) of (nearest town)

WELL PURPOSE:

(home, irrigation, municipal, industrial) home

WELL COMPLETION DATA:

- (1) diameter (inches) 2"
- (2) total depth (feet) 320'
- (3) static water level (feet) 60' below above top of ground.
- (4) casing px 310'
(material) (depth)
(size) If telescope see back.
- (5) screen 10' 310'
(length) (depth to top)
2" px
(size) (material)
- (6) pump crwell 9 hp
(HP) (yield gpm)
ele
(type power)
- (7) electric log no
(yes or no)

(organization running log)

(8) has well bottom plugged

2" ball with valve

DRILLERS REMARKS:


DEPT. OF NATURAL RESOURCES
BUREAU OF LAND & WATER RESOURCES

JAN 15 1982

RECEIVED

If well telescopes please sketch and show depths.

GROUND LEVEL

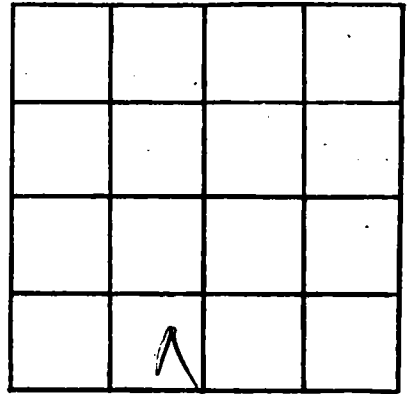

SECTION _____

Please indicate well location X.

ADDITIONAL INFORMATION

A series of horizontal lines for writing additional information, starting below the 'ADDITIONAL INFORMATION' header and extending to the bottom of the page.

If more than one screen, show locations of each on sketch.