

MISSISSIPPI DEPARTMENT OF NATURAL RESOURCES
Bureau of Land and Water Resources
 Southport Mall
 P.O. Box 10631
 Jackson, Mississippi 39209
WATER WELL DRILLERS LOG

Hancock
D 2043

Sept. 1 1983 Wood Well Dlg. Hancock
 date well completed firm name county well located

LANDOWNER: Mike Bignae
Hwy 603
Pass Christian, ms.
 (mailing address)

description of formations encountered	from	to
	<u>Clay</u>	<u>0</u>
<u>sdly clay</u>	<u>14</u>	<u>66</u>
<u>clay</u>	<u>66</u>	<u>276</u>
<u>corke sd</u>	<u>276</u>	<u>315</u>

WELL LOCATION:
 sec. 31 T. 6 N. R. 17 E.
9 miles N of Bahn
 (distance) (direction) (nearest town)

WELL PURPOSE: Home
 (home, irrigation, municipal, industrial)

- WELL COMPLETION DATA:
- (1) diameter (inches) 2"
 - (2) total depth (feet) 315
 - (3) static water level (feet) 35 ^{6' above} top of ground.
 - (4) casing PVC, 305
 (material) (depth)
 (size) if telescope see back.
 - (5) screen 10' (length) (depth to top)
2" (size) PVC (material)
 - (6) pump 1 (HP) 15 (yield gpm)
Elec. (type power)
 - (7) electric log NO (yes or no)
N/A (organization running log)
 - (8) how well bottom plugged BWV

DRILLERS REMARKS: N/A


MISSISSIPPI DEPARTMENT OF NATURAL RESOURCES
 BUREAU OF LAND & WATER RESOURCES

OCT 17 1983

RECEIVED

If well telescopes please sketch and show depths.

GROUND LEVEL

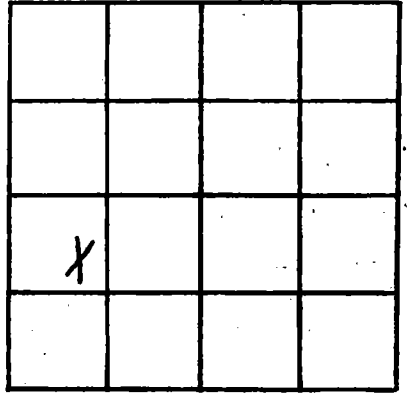

SECTION 31

Please indicate well location X.

ADDITIONAL INFORMATION

If more than one screen,
show locations of each on sketch.