

HANCOCK
D 2044

MISSISSIPPI DEPARTMENT OF NATURAL RESOURCES
Bureau of Land and Water Resources
Southport Mall
P.O. Box 10631
Jackson, Mississippi 39209
WATER WELL DRILLERS LOG

5-25-1984 date well completed
Ward Well Drg. firm name
Hancock county well located

LANDOWNER: Tom Shields
Rt. 2, Box 203 A
Ruckinston, Ms.
(mailing address)

description of formations encountered	from	to
clay	0	26
shaly clay	26	67
clay	67	104
fine sd	104	112
clay	112	164
comp sd	164	188

WELL LOCATION:
sec. 29 T 6 N R. 17 14 E
15 miles N of Bilbo
(distance) (direction) (nearest town)

WELL PURPOSE: Home
(home, irrigation, municipal, industrial)

- WELL COMPLETION DATA:
- (1) diameter (inches) 2"
 - (2) total depth (feet) 185'
 - (3) static water level (feet) 110 ^{below} above top of ground.
 - (4) casing PVC, 175'
(material) (depth)
- if telescope see back.
(size)
 - (5) screen 10', -
(length) (depth to top)
2", PVC
(size) (material)
 - (6) pump owner -
(HP) (yield gpm)
- (type power)
 - (7) electric log no
(yes or no)
N/A
(organization running log)
 - (8) how well bottom plugged BWU

DEPT. OF NATURAL RESOURCES
BUREAU OF LAND & WATER RESOURCES


JUL 20 1984

RECEIVED

DRILLERS REMARKS: Very Slow
Producing Zone
Good SD!

If well telescopes please sketch and show depths.

GROUND LEVEL

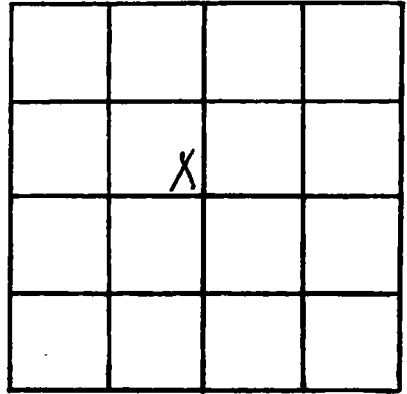

SECTION 29

Please indicate well location X.

ADDITIONAL INFORMATION

If more than one screen,
show locations of each on sketch.