

MISSISSIPPI DEPARTMENT OF NATURAL RESOURCES

Bureau of Land and Water Resources

Southport Mall

P.O. Box 10631

Jackson, Mississippi 39209

WATER WELL DRILLERS LOG

Hancock
D 2045

11-6-84
date well completed

Morison Well Works, Hancock
firm name

county well located

LANDOWNER: Cuevas

description of formations encountered

from to

Kirk Y.M.
(mailing address)

| | | |
|-------------------|-----|-----|
| sand | 0 | 20 |
| mud sand | 20 | 40 |
| mud | 40 | 120 |
| mud sand | 120 | 140 |
| mud | 140 | 160 |
| mud sand | 160 | 180 |
| mud | 180 | 300 |
| mud, sand, gravel | 300 | 330 |
| sand | 330 | 340 |

WELL LOCATION:

sec 22 T 6 N R 116 E
S W
10 miles N of BSL
(distance) (direction) (nearest town)

WELL PURPOSE:
(home, irrigation, municipal, industrial)

WELL COMPLETION DATA:

- (1) diameter (inches) 2"
- (2) total depth (feet) 340'
- (3) static water level (feet) 60' ^{below} _{above} top of ground.
- (4) casing PHWDPC 330'
(material) (depth)
- (size) If telescope see back.
- (5) screen 10' 330'
(length) (depth to top)
- 2" sch 40 to slot
(size) (material)
- (6) pump 1 8
(HP) (yield gpm)
- elec
(type power)
- (7) electric log
(yes or no)
- (organization running log)
- (8) how well bottom plugged seal

DRILLERS REMARKS:


DEPT. OF NATURAL RESOURCES
BUREAU OF LAND & WATER RESOURCES

DEC - 3 1984

RECEIVED

If well telescopes please sketch and show depths.

GROUND LEVEL

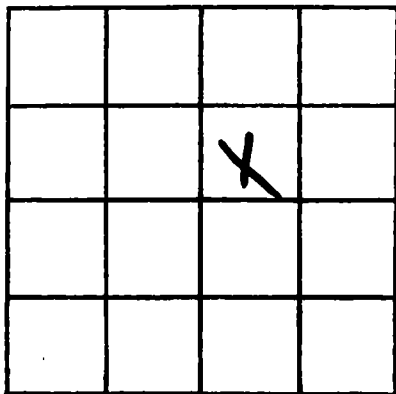

SECTION _____

Please indicate well location X.

ADDITIONAL INFORMATION

If more than one screen,
show locations of each on sketch.