

MISSISSIPPI DEPARTMENT OF NATURAL RESOURCES

Bureau of Land and Water Resources

Southport Mall

P.O. Box 10631

Jackson, Mississippi 39209

WATER WELL DRILLERS LOG

Hancock
D2046

date well completed 12/20 1984 firm name Bradley Pump & Well Serv., Inc., Hancock county well located Hancock

LANDOWNER: <u>Henry Pulsifer</u> <u>P.O. Box 431</u> <u>Kilm, Ms. 39556</u> (mailing address)	description of formations encountered <u>Clay</u> <u>sand</u>	from <u>0</u>	to <u>15</u> <u>80</u>
--	---	------------------	------------------------------

WELL LOCATION:
 sec 31 T 6 S R 14 E
5 miles N. of Kilm.
 (distance) (direction) (nearest town)

WELL PURPOSE: Home
 (home, irrigation, municipal, industrial)

WELL COMPLETION DATA:

(1) diameter (inches) 2"

(2) total depth (feet) 80'

(3) static water level (feet) 18 below top of ground

(4) casing PVC, 60'
 (material) (depth)

2" If telescope see back.
 (size)

(5) screen 10', 60'
 (length) (depth to top)

2", PVC under
 (size) (material)

(6) pump 1/2 5
 (HP) (yield gpm)

230V - Ø
 (type power)

(7) electric log no
 (yes or no)

(organization running log)

(8) how well bottom plugged PVC
sandbars


DRILLERS REMARKS: 10 ft.
tailpipe

DEPT. OF NATURAL RESOURCES
 BUREAU OF LAND & WATER RESOURCES

DEC 31 1984
RECEIVED

If well telescopes please sketch and show depths.

GROUND LEVEL

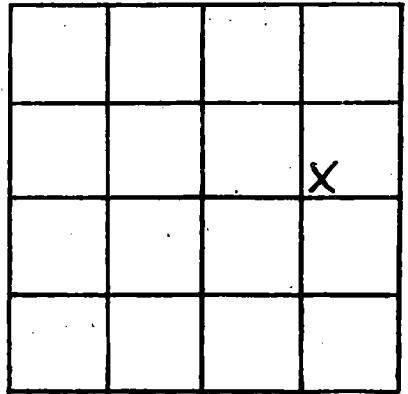

SECTION 31

Please indicate well location X.

ADDITIONAL INFORMATION

If more than one screen, show locations of each on sketch.