

MISSISSIPPI DEPARTMENT OF NATURAL RESOURCES
Bureau of Land and Water Resources
 Southport Mall
 P.O. Box 10631
 Jackson, Mississippi 39209
WATER WELL DRILLERS LOG

Hancock
D 2048

2-23-85 19 Gulf Coast Waterwell HANCOCK
 date well completed firm name county well located

LANDOWNER: GERALD SMITH
P.O. BOX 1545
CHALMETTE LA
 (mailing address)

description of formations encountered	from	to
<u>SANDY RED CLAY</u>	<u>0</u>	<u>30</u>
<u>RED SAND</u>	<u>30</u>	<u>50</u>
<u>SOFT RED CLAY</u>	<u>50</u>	<u>90</u>
<u>Muddy CLAY SAND</u>	<u>90</u>	<u>150</u>
<u>BLUE CLAY</u>	<u>150</u>	<u>180</u>
<u>SANDY CLAY</u>	<u>180</u>	<u>260</u>
<u>CLEAN MED SAND</u>	<u>260</u>	<u>300</u>

WELL LOCATION:
 sec 7 T 6 R 14
 S W
8 miles NORTH of KILN
 (distance) (direction) (nearest town)

WELL PURPOSE: Home
 (home, irrigation, municipal, industrial)

WELL COMPLETION DATA:

(1) diameter (inches) 4"

(2) total depth (feet) 300'

(3) static water level (feet) 64 below above top of ground.

(4) casing PVC, 290,
 (material) (depth)
4 IN if telescope see back.
 (size)

(5) screen 10', 290
 (length) (depth to top)
4", PVC
 (size) (material)

(6) pump 1, 12
 (HP) (yield gpm)
230 V
 (type power)

(7) electric log NO
 (yes or no)
 (organization running log)

(8) how well bottom plugged SAND SHANK
PVC


RECEIVED
 FEB 28 1985

Department of Natural Resources
 Bureau of Land & Water Resources

DRILLERS REMARKS:

If well telescopes please sketch and show depths.

GROUND LEVEL

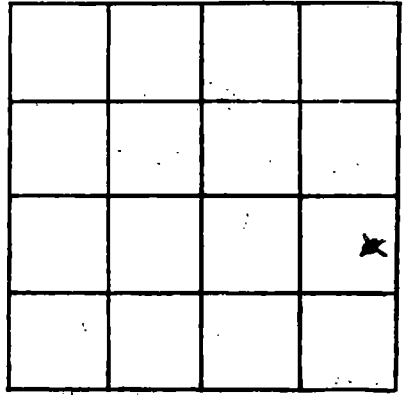

SECTION 7

Please indicate well location X.

ADDITIONAL INFORMATION

If more than one screen,
show locations of each on sketch.