

MISSISSIPPI DEPARTMENT OF NATURAL RESOURCES

Bureau of Land and Water Resources

Southport Mall

P.O. Box 10631

Jackson, Mississippi 39209

WATER WELL DRILLERS LOG

HANCOCK
D2050

12-19

date well completed

PS Broden Pump Well Co

firm name

Hancock

county well located

LANDOWNER James Kohner

Rt 1 Box 286

Pass Christian, Miss. 39571

(mailing address)

WELL LOCATION:

sec. 27 T. 6 N. R. 14 E.

S. W. Y.

3 miles E of Vidalia

(distance) (direction) (nearest town)

WELL PURPOSE:

(home, irrigation, municipal, industrial)

Home

WELL COMPLETION DATA:

- (1) diameter (inches) 2"
- (2) total depth (feet) 340
- (3) static water level (feet) 60 below above top of ground.
- (4) casing 2" PVC Total
(material) (depth)
2"
(size) If telescope see back.
- (5) screen 10 320
(length) (depth to top)
2" PVC .008
(size) (material)
- (6) pump 1 8
(HP) (yield gpm)
220V 1Ø
(type power)
- (7) electric log NO
(yes or no)

(organization running log)

2" PVC Sand Shack

(8) how well bottom plugged


description of formations encountered

from to

Surface	0	8
Red Clay	8	70
White Sand	70	82
White Clay	82	122
Sand	122	130
Blue Clay	130	240
Sand & Clay Brecks	240	285
Grey Sand	285	340

DRILLERS REMARKS:

10 FT Tail Pipe

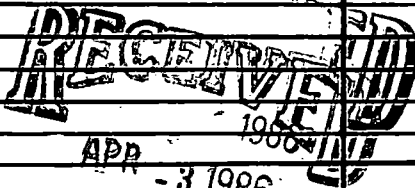

Department of Natural Resources
Bureau of Land & Water Resources

If well telescopes please sketch and show depths.

GROUND LEVEL

X			

SECTION 27

Please indicate well location X.

ADDITIONAL INFORMATION

If more than one screen, show locations of each on sketch.