

MISSISSIPPI DEPARTMENT OF NATURAL RESOURCES

Bureau of Land and Water Resources

Southport Mall

P.O. Box 10631

Jackson, Mississippi 39209

WATER WELL DRILLERS LOG

Hancock  
D 2051

Aug. 12 1986  
date well completed

86 Ward Well Dr.  
firm name

Hancock  
county well located

LANDOWNER Tommy Busser  
P.O. Box 445  
Kiln, ms.  
(mailing address)

description of formations encountered	from	to
clay	0	12
sd	12	25
sd/clay	25	68
clay	68	85
sd	85	106
clay - silt	106	212
core sd	212	273

WELL LOCATION:  
sec 30 T 6 N R 14 E  
10 miles N of Kiln  
(distance) (direction) (nearest town)

WELL PURPOSE: Home  
(home, irrigation, municipal, industrial)

- WELL COMPLETION DATA:
- (1) diameter (inches) 2"
  - (2) total depth (feet) 273
  - (3) static water level (feet) 45 <sup>below</sup> <sub>above</sub> top of ground.
  - (4) casing PVC, 263  
(material), (depth)  
— if telescope see back.  
(size)
  - (5) screen 10, -  
(length), (depth to top)  
2", PVC  
(size), (material)
  - (6) pump 1, 12  
(HP), (yield gpm)  
elec.  
(type power)
  - (7) electric log no  
(yes or no)  
N/A  
(organization running log)
  - (8) how well bottom plugged BWU

**RECEIVED**


OCT 06 1986

Department of Natural Resources  
Bureau of Land & Water Resources

DRILLERS REMARKS: N/A

If well telescopes please sketch and show depths.

GROUND LEVEL

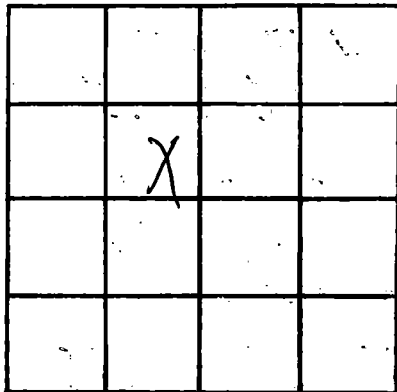

SECTION 30

Please indicate well location X.

ADDITIONAL INFORMATION

If more than one screen,  
show locations of each on sketch.