

MISSISSIPPI DEPARTMENT OF NATURAL RESOURCES
Bureau of Land and Water Resources

P.O. Box 10631
Jackson, Mississippi 39209
WATER WELL DRILLERS LOG

COUNTY WELL LOCATED
Clarendon

WELL NUMBER CODED PERMIT NUMBER
D7052 0239

NAME OF DRILLING FIRM
MCGILL PUMP & WELLS
RT1 BOX 1643 CANAL RD
GUPT, MS 39503

DATE WELL COMPLETED
1-1-87

NAME & MAILING ADDRESS OF LANDOWNER
Herman Swilley
Rt. 1, Box 570
Pasc Christian Ms.

WELL LOCATION: SEC TOWNSHIP RANGE
9 6 N 14 EW

DISTANCE DIRECTION NEAREST TQWN
6 Miles South of DEQUIS, MISSISSIPPI

OTHER LANDMARK
02603

WELL PURPOSE: Home, Irrigation, Municipal, Industrial, Fish Pond, etc.

PUMP DATA

PUMP TYPE (Circle One):
Submersible, Turbine, Jet, Flowing Well,
Other (Describe) None

POWER TYPE (Circle One):
Electric, Tractor, Diesel, Gasoline, Butane,
Other (Describe) _____

Pump Capacity (GPM) No. of Stages Setting Depth
_____ FT.

PUMP TEST
Well yielded 8 GPM with
a drawdown of 3 ft.
after 1 hours of pumping

WELL DATA

Well Depth <u>240'</u>	Casing Diameter (In.) <u>2"</u>	Casing Length (Ft.) <u>240'</u>
Type of Casing <u>PVC</u>	Hole Depth <u>240'</u>	Depth to Static Water Level <u>110'</u>

TYPE OF COMPLETION: (Circle One or More):
 Gravel Packed, Underreamed, Telescoped,
 Natural Development, Open Hole, Other
(Describe) _____

Top of Lap Pipe or Reduction in Casing
FEET IF TELESCOPED OR MORE THAN ONE SCREEN: USE BACK PAGE

LOG DATA

TYPE OF LOG RUN (Circle One):
No Log Run, Electric, Gamma Ray, Density, Sonic, Neutron,
Other (Describe) _____

Name of Organization Running Log

SCREEN DATA

Diameter - Inches <u>2"</u>	Length - Feet <u>10'</u>	Slot Size - Inches <u>6ths</u>
Screen Type <u>PVC</u>	Depth to Bottom - Feet <u>240'</u>	

GEOLOGIC DATA (Office Use Only)

Surface Elev.	Geologic Unit	Unit Thickness	Depth to Top
Subs. SWL	Date	Analysis	Aquifer Test

Driller's Remarks

RECEIVED

DESCRIPTION OF FORMATIONS ENCOUNTERED	FROM	TO	DEPTH (Continued)	FROM	TO


JAN 14 1987

Department of Natural Resources
Bureau of Land & Water Resources

IF MORE SPACE IS NEEDED, USE BACK

If well telescopes please sketch and show depths.

GROUND LEVEL

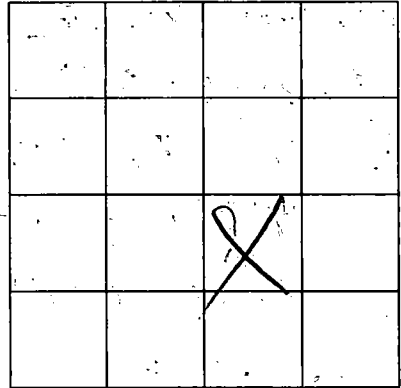

SECTION _____

Please indicate well location X.

ADDITIONAL INFORMATION

RECEIVED

NOV 14 1981

U.S. GEOLOGICAL SURVEY
WATER RESOURCES DIVISION
WASHINGTON, D.C. 20506

If more than one screen, show location of each on sketch.