

MISSISSIPPI DEPARTMENT OF NATURAL RESOURCES

Bureau of Land and Water Resources

Southport Mall

P.O. Box 10631

Jackson, Mississippi 39209

WATER WELL DRILLERS LOG

13

HANCOCK
D 2054
1/30/81

Jan 30 1981 Suncoast Well Drilling Hancock
date well completed firm name county well located

LANDOWNER: Beth Collins
Rt. 1 Box 435-A
Law Christian, Ms.
(mailing address)

description of formations encountered	from	to
<u>Sand</u>	<u>0</u>	<u>30</u>
<u>white clay</u>	<u>30</u>	<u>90</u>
<u>Blue Clay</u>	<u>90</u>	<u>260</u>
<u>Low sand</u>	<u>260</u>	<u>278</u>
<u>Course sand</u>	<u>278</u>	<u>290</u>

WELL LOCATION:
sec 20 T 6 N R 14 E
12 miles N of Kila
(distance) (direction) (nearest town)

WELL PURPOSE: Home
(home, irrigation, municipal, industrial)

WELL COMPLETION DATA:

(1) diameter (inches) 2"

(2) total depth (feet) 290'

(3) static water level (feet) 30' ^{below} above top of ground.

(4) casing PVC 280'
(material) (depth)
1 (size) if telescope see back.

(5) screen 10' 280'
(length) (depth to top)
2" PVC
(size) (material)

(6) pump 1 12
(HP) (yield gpm)
electric
(type power)

(7) electric log
(yes or no)

(organization running log)

(8) how well bottom plugged Sand
Sharp

DRILLERS REMARKS:


DEPT. OF NATURAL RESOURCES
BUREAU OF LAND & WATER RESOURCES

MAY 18 1981

RECEIVED

If well telescopes please sketch and show depths.

GROUND LEVEL

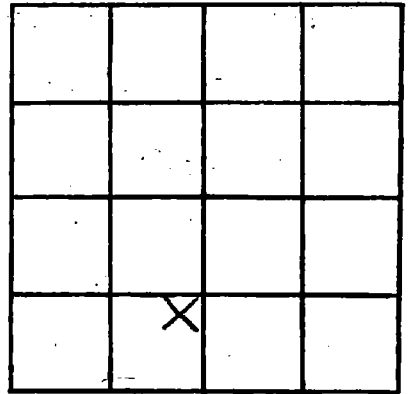

SECTION 20

Please indicate well location X.

ADDITIONAL INFORMATION

If more than one screen,
show locations of each on sketch.