

MISSISSIPPI DEPARTMENT OF NATURAL RESOURCES

Bureau of Land and Water Resources

Southport Mall

P.O. Box 10631

Jackson, Mississippi 39209

WATER WELL DRILLERS LOG

HANCOCK
D 2055
3/26/81

March 26 1981 Duncan Well Drilling (Lancost)
date well completed firm name county well located

LANDOWNER: Eddie Cuevas
Rt. 1 Box 436
Pass Christian, Ms
(mailing address)

description of formations encountered	from	to
<u>sand</u>	<u>0</u>	<u>20</u>
<u>white clay</u>	<u>20</u>	<u>90</u>
<u>Blue Clay</u>	<u>90</u>	<u>260</u>
<u>fine sand</u>	<u>260</u>	<u>278</u>
<u>coarse sand</u>	<u>278</u>	<u>290</u>

WELL LOCATION:
sec 20 T 6 N R 14 E
12 miles N of Bald
(distance) (direction) (nearest town)

WELL PURPOSE: Home
(home, irrigation, municipal, industrial)

- WELL COMPLETION DATA:
- (1) diameter (Inches) 2"
 - (2) total depth (feet) 290 ft.
 - (3) static water level (feet) 30" below above top of ground.
 - (4) casing PVC, 280'
(material) (depth)
— (size) if telescope see back.
 - (5) screen 10', 280'
(length) (depth to top)
2", PVC
(size) (material)
 - (6) pump 1, 12
(HP) (yield gpm)
electric
(type power)
 - (7) electric log —
(yes or no)
—
(organization running log)
 - (8) how well bottom plugged sand
shark

DEPT. OF NATURAL RESOURCES
BUREAU OF LAND & WATER RESOURCES


MAY 28 1981

RECEIVED

DRILLERS REMARKS:
—
—
—

If well telescopes please sketch and show depths.

GROUND LEVEL

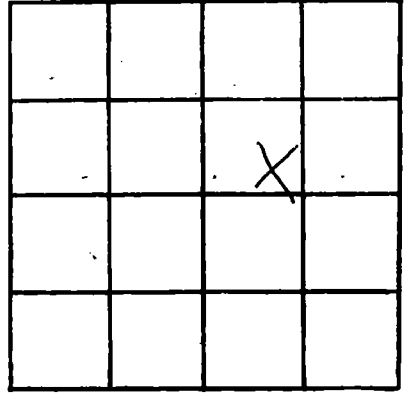

SECTION 20

Please indicate well location X.

ADDITIONAL INFORMATION

If more than one screen, show locations of each on sketch.