

MISSISSIPPI DEPARTMENT OF NATURAL RESOURCES
Bureau of Land and Water Resources

P.O. Box 10631
Jackson, Mississippi 39209
WATER WELL DRILLERS LOG

COUNTY WELL LOCATED
Monroe

WELL NUMBER
D2056

CODED

PERMIT NUMBER

NAME OF DRILLING FIRM
Wood Well Drg.

DATE WELL COMPLETED
June 29 1987

NAME & MAILING ADDRESS OF LANDOWNER
J. J. Beaux

P.O. Box 236

Kiln, ms.

WELL LOCATION: / SEC TOWNSHIP RANGE
20 6 N 14 E

DISTANCE DIRECTION NEAREST TOWN
10 Miles N of Kiln

OTHER LANDMARK

WELL PURPOSE: Home, Irrigation, Municipal, Industrial, Fish Pond, etc.
Home

PUMP DATA

PUMP TYPE (Circle One):
 Submersible Turbine Jet Flowing Well,
Other (Describe) _____

POWER TYPE (Circle One):
 Electric Tractor Diesel Gasoline Butane,
Other (Describe) _____

Pump Capacity (GPM)	No. of Stages	Setting Depth
<i>35</i>	<i>8</i>	<i>120</i> FT.

PUMP TEST

Well yielded _____ GPM with _____ ft. after _____ hours of pumping

RECEIVED

WELL DATA

Well Depth <i>420'</i>	Casing Diameter (In.) <i>4" x 2"</i>	Casing Length (Ft.) <i>400</i>
Type of Casing <i>Sk. 40 PVC</i>	Hole Depth <i>420</i>	Depth to Static Water Level <i>-65 ft.</i>

TYPE OF COMPLETION: (Circle One or More):
Gravel Packed, Underreamed, Telescoped, Natural Development, Open Hole, Other
(Describe) *Backwash & air*

Top of Lap Pipe or Reduction in Casing

FEET IF TELESCOPED OR MORE THAN ONE SCREEN: USE BACK PAGE

AUG 17 1987

LOG DATA

TYPE OF LOG RUN (Circle One):
Electric, Gamma Ray, Density, Sonic, Neutron, No Log Run, Other (Describe) _____

Name of Organization Running Log

SCREEN DATA

Diameter - Inches <i>2"</i>	Length - Feet <i>20 ft.</i>	Slot Size - inches <i>8 Slot</i>
Screen Type <i>Sk. 80 PVC</i>	Depth to Bottom - Feet <i>-</i>	

GEOLOGIC DATA (Office Use Only)

Surface Elev.	Geologic Unit	Unit Thickness	Depth to Top
Subs. SWL	Date	Analysis	Aquifer Test


Driller's Remarks
N/A

DESCRIPTION OF FORMATIONS ENCOUNTERED	FROM	TO	FORMATIONS (Continued)	FROM	TO
<i>Sandy clay</i>	<i>0</i>	<i>40</i>			
<i>clay</i>	<i>40</i>	<i>85</i>			
<i>Sandy sd</i>	<i>85</i>	<i>95</i>			
<i>clay</i>	<i>95</i>	<i>230</i>			
<i>Coarse sd</i>	<i>230</i>	<i>326</i>			
<i>clay</i>	<i>326</i>	<i>330</i>			
<i>Coarse sd</i>	<i>330</i>	<i>420</i>			

IF MORE SPACE IS NEEDED, USE BACK

If well telescopes please sketch and show depths.

GROUND LEVEL

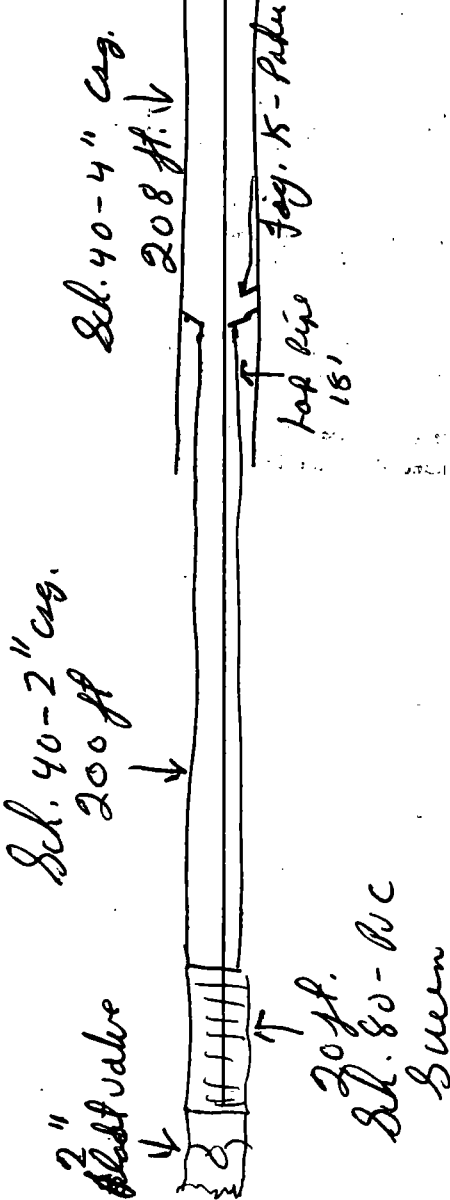

If more than one screen, show location of each on sketch.

	X		

SECTION 20

Please indicate well location X.

ADDITIONAL INFORMATION

Multiple horizontal lines for additional information.