

Hancock

MISSISSIPPI DEPARTMENT OF ENVIRONMENTAL QUALITY

Office of Land and Water Resources

P. O. Box 10631
Jackson, MS 39289-0631

WATER WELL DRILLERS LOG

COUNTY WELL LOCATED
Hancock

WELL NUMBER 0-2078 CODED

DATE WELL COMPLETED
2-01-01

PERMIT NUMBER
0-239

NAME OF DRILLING FIRM
ML Side pump & well

NAME & MAILING ADDRESS OF LANDOWNER
Reading
Jamoneo Jackson
Kilm, Ms, 3970

WELL LOCATION: SEC. 33 TOWNSHIP 6 RANGE 14
S E

DISTANCE 20 Miles DIRECTION E of NEAREST TOWN Grpt

OTHER LANDMARK

WELL PURPOSE: Home Irrigation, Municipal, Industrial, Fish Pond, etc.

PUMP DATA

PUMP TYPE (Circle One):
Submersible, Turbine, Jet, Flowing Well,
Other (Describe)

POWER TYPE (Circle One):
 Electric, Tractor, Diesel, Gasoline, Butane,
Other (Describe) H/P 1

Pump Capacity (GPM) 8 No. of Stages 2 Setting Depth 60 FT.

PUMP TEST
Well yielded 8 GPM with
a drawdown of 5 ft.
after 5 hours of pumping

WELL DATA

Well Depth <u>160</u>	Casing Diameter (In.) <u>2"</u>	Casing Length (Ft.) <u>140</u>
Type of Casing <u>pvc</u>	Hole Depth <u>160</u>	Depth to Static Water Level <u>40</u>

LOG DATA

TYPE OF LOG RUN (Circle One):
No Log Run, Electric, Gamma Ray, Density, Sonic, Neutron,
Other (Describe) hand written

Name of Organization Running Log

TYPE OF COMPLETION: (Circle One or More):
 Gravel Packed, Underreamed, Telescoped,
 Natural Development, Open Hole, Other
(Describe)

GEOLOGIC DATA (Office Use Only)

Surface Elev.	Geologic Unit	Unit Thickness	Depth to Top
Subs. SWL	Date	Analysis	Aquifer Test

WELL GROUTED TO A DEPTH OF 10 FEET
Type Grout (circle one): Cement, Bentonite, or Mix

SCREEN DATA

Diameter - Inches <u>2"</u>	Length - Feet <u>20'</u>	Slot Size - Inches <u>.006</u>
Screen Type <u>pvc</u>	Depth to Bottom - Feet <u>160</u>	

Driller's Remarks

Top of Lap Pipe or Reduction in Casing

FEET IF TELESCOPED OR MORE THAN ONE SCREEN: USE BACK PAGE

DESCRIPTION OF FORMATIONS ENCOUNTERED	FROM	TO
<u>sand</u>	<u>0</u>	<u>40</u>
<u>sand</u>	<u>60</u>	<u>80</u>
<u>sand and</u>	<u>80</u>	<u>120</u>
<u>sand</u>	<u>120</u>	<u>160</u>


FORMATIONS (Continued)	FROM	TO

IF MORE SPACE IS NEEDED, USE BACK

REC'D AUG 13 2001

If well telescopes please
sketch and show depths.

GROUND LEVEL

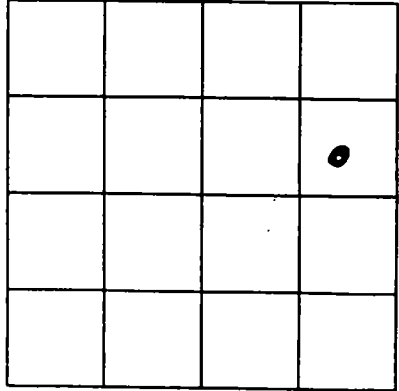

SECTION _____

Please indicate well location X.

ADDITIONAL INFORMATION

If more than one screen,
show location of each on sketch.