




If well telescopes please sketch and show depths.

GROUND LEVEL

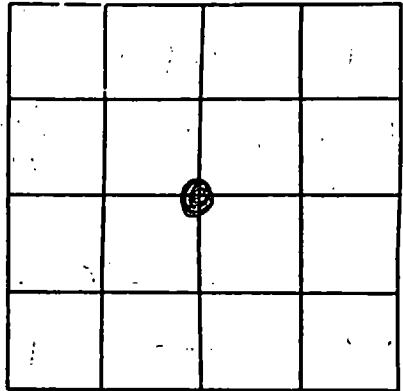

SECTION \_\_\_\_\_

Please indicate well location X.

|                     |               |               |
|---------------------|---------------|---------------|
| Pump Capacity (GPM) | No. of Stages | Setting Depth |
| 3                   | 3             | 150 FT.       |

PUMP TEST

Well yielded 3 GPM with  
 a drawdown of 5 ft.  
 after 5 hours of pumping

LOG DATA

TYPE OF LOG RUN (Circle One): No Log Run, Electric, Gamma Ray, Density, Sonic, Neutron, Other (Describe) handwritten

Name of Organization Running Log

GEOLOGIC DATA (Office Use Only)

|               |               |                |              |
|---------------|---------------|----------------|--------------|
| Surface Elev. | Geologic Unit | Unit Thickness | Depth to Top |
| Subs. SWL     | Date          | Analysis       | Aquifer Test |

Driller's Remarks

If more than one screen, show location of each on sketch.