

Hancock
E 15
11-12-69

CODED
 CODED

MISSISSIPPI
 BOARD OF WATER COMMISSIONERS
 416 North State Street
 Jackson, Mississippi 39201

WATER WELL DRILLERS LOG

Hancock County

11-12 1969 E. J. Waterwell Serv. _____
 date well completed firm name county well located


LANDOWNER:	description of formations encountered	from	to
<u>Donald P. Peden</u>			
<u>Rt. 1. Piquemiss</u> (mailing address)	<u>Five white fsd.</u>	<u>20</u>	<u>45</u>
	<u>Blue c. clay</u>	<u>45</u>	<u>218</u>
	<u>med Blue silt</u>	<u>218</u>	<u>247</u>
WELL LOCATION:			
sec. <u>15</u> T. <u>2</u> N. R. <u>12</u> E.			
<u>12</u> miles <u>W.</u> of <u>Rt. 1</u>			
(distance) (direction) (nearest town)			
WELL PURPOSE: <u>Home</u>			
(home, irrigation, municipal, industrial)			
WELL COMPLETION DATA:			
(1) diameter (inches) <u>4.5</u>			
(2) total depth (feet) <u>247</u>			
(3) static water level (feet) <u>37</u> below above top of ground.			
(4) casing <u>2" Galv.</u> <u>242</u> (material) (depth)			
<u>2</u> if telescope see back. (size)			
(5) screen <u>5</u> <u>242-247</u> (length) (depth to top)			
<u>2</u> <u>5.5</u> (size) (material)			
(6) pump <u>1</u> <u>600</u> (HP) (yield gpm)			
<u>Elect</u> (type power)			
(7) electric log <u>NO</u> (yes or no)			
(organization running log)			
(8) how well bottom plugged <u>shoe</u>			
DRILLERS REMARKS:			

DEC 18 1969

MISS. BD. OF
 WATER COMM.

If well telescopes please sketch and show depths.

GROUND LEVEL

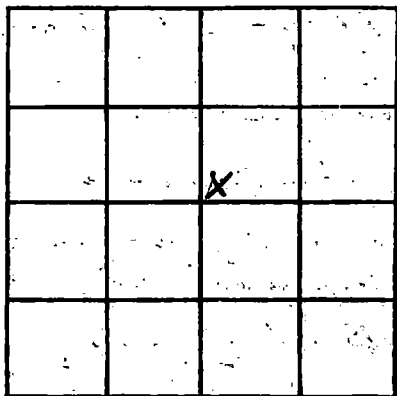

SECTION 15

Please indicate well location X.

ADDITIONAL INFORMATION

If more than one screen, show locations of each on sketch.