

E 28
7-21-60

WATER WELL DRILLERS LOG

HANCOCK Co.
CODED

Date: 7-21, 1960, Driller: Quick & Grace County: _____

(Name) _____ From _____ To _____

(1) Owner of Land: J. J. Frison
(Name)
Santa Rosa Mini
(Address)

(2) Location: _____ 1/4, _____ 1/4, Sec. 12 T 7 R 17
1.0 miles South of Osage
(distance) (direction) (Nearest Town)

(3) Topography: _____
(Hilly) (Flat) (Level)

(4) Purpose of Well: Domestic
(Domestic Irrigation
Municipal, Industrial, Other)

Description & Color of Materials Sand, Clay, Red Clay, Shell, etc.	Thick- ness Feet	Depth Feet
<u>Surface Clay</u>	<u>0</u>	<u>15</u>
<u>" " Sand</u>	<u>15</u>	<u>85</u>
<u>Blue clay</u>	<u>85</u>	<u>325</u>
<u>Sand</u>	<u>325</u>	<u>340</u>
<u>Blue clay</u>	<u>340</u>	<u>410</u>
<u>Sand</u>	<u>410</u>	<u>520</u>
<u>Blue clay</u>	<u>520</u>	<u>675</u>
<u>Sand</u>	<u>675</u>	<u>785</u>
<u>Blue clay</u>	<u>785</u>	<u>920</u>
<u>good sand</u>	<u>920</u>	<u>966</u>

Information upon completion of well:

(1) Diameter 2 inches.

(2) Total Depth 966 feet.

(3) Water Level Flow feet below top of ground.

(4) Cased to _____, Size _____

(5) Screen: Size 2", Length 20'

(6) Were any formations sealed against pollution?
_____ yes, No no.

CODED


966'

Total Depth

If YES depth of formation _____

Why _____

Drillers Remarks: 60 gal Per
Minute, 30 lbs
Pressure
"good well"

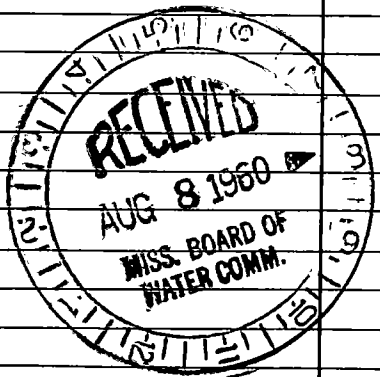

(Use Back Side)

Well No. 3

