

Hancock
E 32
3-20-70

MISSISSIPPI
BOARD OF WATER COMMISSIONERS
416 North State Street
Jackson, Mississippi 39201

COPIED

WATER WELL DRILLERS LOG
NEIL LUMPKIN WELL DRILLING SERVICE

3-20-70
date well completed 1970
Hancock, MISSISSIPPI
firm name
Hancock
county well located

LANDOWNER: W.C. Seal
Picayune, Miss.
Rt. 3, Box 345
(mailing address)

description of formations encountered	from	to
Surface clay	0	15
Surface sand	15	100
Blue clay, hard	100	300
Band, fine to better	300	384

WELL LOCATION:
sec. 32 T. 7 S. R. 16 W.
14 miles SE of Picayune
(distance) (direction) (nearest town)

WELL PURPOSE: Church
(home, irrigation, municipal, industrial)

- WELL COMPLETION DATA:
- diameter (inches) 2"
 - total depth (feet) 384
 - static water level (feet) 42 below top of ground.
 - casing galv. (material) (depth)
2" (size) if telescope see back.
 - screen 5' (length) (depth to top)
2" (size) St. St. (material)
 - pump 1/2 (HP) (yield gpm)
electric (type power)
 - electric log no. (yes or no)

COPIED

(organization running log)

(8) how well bottom plugged Johnson
Back pressure valve


DRILLERS REMARKS:
Johns

APR 13 1970

MISS. BD. OF
WATER COMM.

If well telescopes please sketch and show depths.

GROUND LEVEL

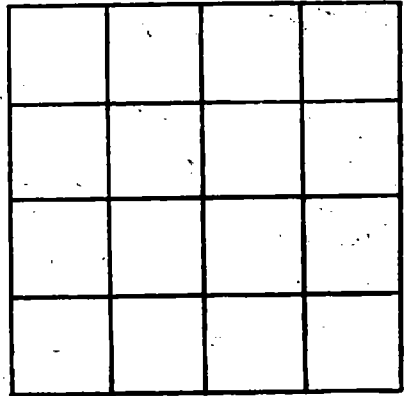

SECTION _____

Please indicate well location X.

ADDITIONAL INFORMATION

If more than one screen, show locations of each on sketch.