

MISSISSIPPI
BOARD OF WATER COMMISSIONERS
416 North State Street
Jackson, Mississippi 39201

CODED

WATER WELL DRILLERS LOG

HANCOCK
E 33
10-17-70

10-17 1970 Ed J. Worster Wellson Hancock
date well completed firm name county well located

LANDOWNER:

Jony Davis
Rt. Picayune, Miss
(mailing address)

description of formations encountered

from to

<u>Red clay</u>	<u>0</u>	<u>16</u>
<u>Coarse whit sd.</u>	<u>16</u>	<u>28</u>
<u>White & blue clay</u>	<u>28</u>	<u>42</u>
<u>Blue clay</u>	<u>42</u>	<u>150</u>
<u>Fine blue sd.</u>	<u>150</u>	<u>165</u>
<u>Blue clay</u>	<u>165</u>	<u>190</u>
<u>med blue sd.</u>	<u>190</u>	<u>216</u>

WELL LOCATION:

sec 21 T 7 N R 16 E
5 miles East of Picayune
(distance) (direction) (nearest town)

WELL PURPOSE: Home
(home, irrigation, municipal, industrial)

WELL COMPLETION DATA:

- (1) diameter (inches) 4 5/8
- (2) total depth (feet) 216
- (3) static water level (feet) 24 below top of ground
- (4) casing 2" Galv. 2 1/2"
(material) (depth)
- 2" If telescope see back.
(size)
- (5) screen 5' 211-216
(length) (depth to top)
- 2" S.S.
(size) (material)
- (6) pump ~~Elect~~ 600 gpm
(HP) (yield gpm)
- Elect
(type power)
- (7) electric log NO
(yes or no)

CODED

(organization running log)

(8) how well bottom plugged slow


JAN 26 1971

DRILLERS REMARKS:

MISS. RD. OF
WATER COMM.

If well telescopes please sketch and show depths.

GROUND LEVEL

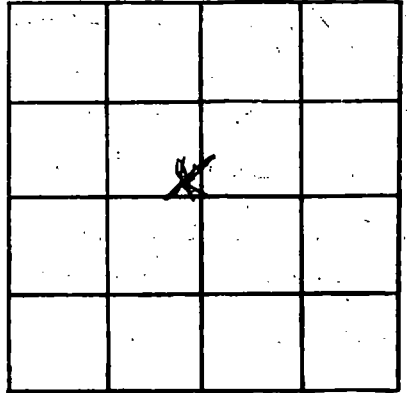

SECTION 21

Please indicate well location X.

ADDITIONAL INFORMATION

If more than one screen, show locations of each on sketch.