

HANCOCK
E 34
10-22-70

MISSISSIPPI
 BOARD OF WATER COMMISSIONERS
 416 North State Street
 Jackson, Mississippi 39201

CODED

WATER WELL DRILLERS LOG

10-22 1970 F. J. Water Well Serv HANCOCK
 date well completed firm name county well located

LANDOWNER:	description of formations encountered	from	to
<u>Johnny Fred Lee</u>	<u>Red clay</u>	<u>0</u>	<u>16</u>
<u>Rt. Piquette Miss</u> (mailing address)	<u>Coarse white sd</u>	<u>16</u>	<u>40</u>
WELL LOCATION:	<u>Blue clay</u>	<u>40</u>	<u>180</u>
sec. <u>21</u> T. <u>7</u> N. R. <u>16</u> E	<u>Fine Blue sd</u>	<u>180</u>	<u>183</u>
<u>5</u> miles <u>East</u> of <u>Piquette</u> (distance) (direction) (nearest town)	<u>Fine Blue sd</u>		
WELL PURPOSE: <u>Home</u> (home, irrigation, municipal, industrial)	<u>med. clay str</u>	<u>183</u>	<u>225</u>
WELL COMPLETION DATA:	<u>Blue clay</u>	<u>225</u>	<u>313</u>
(1) diameter (inches) <u>4.5</u>	<u>med. Blue sd.</u>	<u>313</u>	<u>367</u>
(2) total depth (feet) <u>367</u>			
(3) static water level (feet) <u>16</u> below top of ground.			
(4) casing <u>Galv.</u> , <u>362</u> , (material) (depth)			
<u>2"</u> (size) If telescope see back.			
(5) screen <u>5'</u> , <u>367-362</u> (length) (depth to top)			
<u>2"</u> , <u>S.S.</u> (size) (material)			
(6) pump <u>1</u> , <u>600 G.P.M.</u> (HP) (yield gpm)			
<u>Elect</u> (type power)			
(7) electric log <u>NO</u> (yes or no)			
<u></u> (organization running log)			
(8) how well bottom plugged <u>skoe</u>			
DRILLERS REMARKS:			


CODED

JAN 26 1971

MISS. SD. &
 WATER LOG.

If well telescopes please sketch and show depths.

GROUND LEVEL

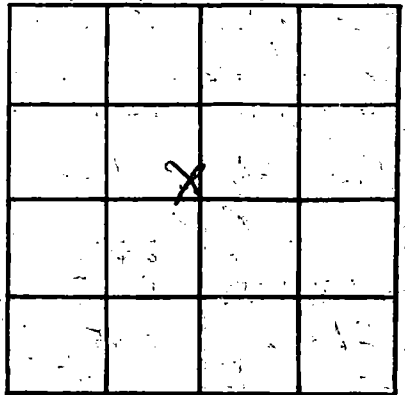

SECTION 21

Please indicate well location X.

ADDITIONAL INFORMATION

If more than one screen, show locations of each on sketch.