

CODED

MISSISSIPPI  
BOARD OF WATER COMMISSIONERS  
416 North State Street  
Jackson, Mississippi 39201

WATER WELL DRILLERS LOG *Hancock County*

HANCOCK  
E36  
5-15-73

5-15 1973 *Earl Penton water well serv.*  
date well completed firm name county well located

LANDOWNER:	description of formations encountered	from	to
<i>Mr. Richard Rauh</i> <i>Picayune miss.</i> (mailing address)			
WELL LOCATION:	<i>Coarse white</i>	<i>27</i>	<i>46</i>
sec <i>25 T 7 N</i> R <i>16 E</i>			
<i>10</i> miles <i>West</i> of <i>Kid</i>			
(distance) (direction) (nearest town)			
WELL PURPOSE: <i>Home</i> (home, irrigation, municipal, industrial)			
WELL COMPLETION DATA:			
(1) diameter (inches) <i>4 1/2</i>			
(2) total depth (feet) <i>46</i>			
(3) static water level (feet) <i>15</i> below above top of ground.			
(4) casing <i>P.V.C.</i> <i>41'</i> (material) (depth)			
<i>2"</i> (size) if telescope see back.			
(5) screen <i>5'</i> <i>41</i> (length) (depth to top)			
<i>2</i> <i>P.V.C.</i> (size) (material)			
(6) pump <i>1</i> <i>450</i> (HP) (yield gpm)			
<i>Elect.</i> (type power)			
(7) electric log <i>NO</i> (yes or no)			
(organization running log)			
(8) how well bottom plugged <i>Shoe</i>			
DRILLERS REMARKS:			


CODED

NOV 8 1973

MISS. BO. OF  
WATER COM.

If well telescopes please sketch and show depths.

GROUND LEVEL

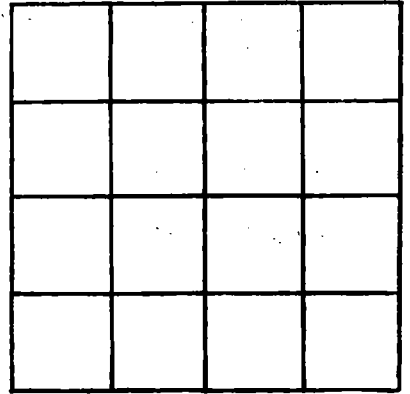

SECTION \_\_\_\_\_

Please indicate well location X.

ADDITIONAL INFORMATION

If more than one screen,  
show locations of each on sketch.