

E 46
 Hancock Co.
 10-24-83

MISSISSIPPI DEPARTMENT OF NATURAL RESOURCES
 Bureau of Land and Water Resources
 WATER WELL SERVICE
 ROUTE 4 BOX 1402 Southport, MS 38620
 CARRIER, MS 38620 P.O. Box 1063
 PHONE 783-5324
 805 PENTON & SON
 WATER WELL SERVICE
 ROUTE 1 JACKSON, MISSISSIPPI
 CARRIER, MS 38620
 PHONE 783-5324
CODED

10/94 1983 date well completed firm name Hancock Co. county well located

LANDOWNER: Wayne Mitchell
B.T. Box 218 Carrier
MS 39426
 (mailing address)

description of formations encountered	from	to
Red shale	0	70
Blue shale	30	975
Blue sand	975	1018

WELL LOCATION:
 sec. 19 T. 7 N. R. 16 E.
12 miles (distance) E (direction) Waynes (nearest town)

WELL PURPOSE: home
 (home, irrigation, municipal, industrial)

WELL COMPLETION DATA:

(1) diameter (inches) 2"

(2) total depth (feet) 1018

(3) static water level (feet) 12' below top of ground.

(4) casing PVE, 1018
 (material) (depth)
 (size) if telescope see back.

(5) screen 2'x16", 1003
 (length) (depth to top)
12, PVC
 (size) (material)

(6) pump 3, 1012
 (HP) (yield gpm)
Electric
 (type power)


(7) electric log NO
 (yes or no)
 (organization running log)

(8) how well bottom plugged plugged

DRILLERS REMARKS:

If well telescopes please sketch and show depths.

GROUND LEVEL

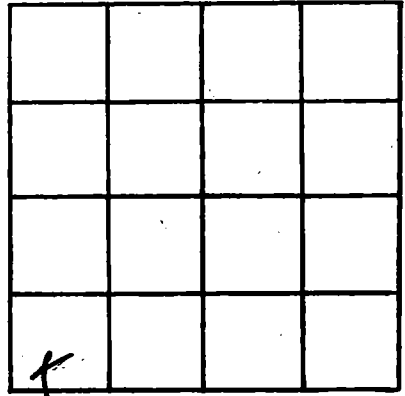

SECTION _____

Please indicate well location X.

ADDITIONAL INFORMATION

Multiple horizontal lines for writing additional information.

DEPT. OF NATURAL RESOURCES
BUREAU OF LAND & WATER RESOURCES

NOV 18 1983

RECEIVED

If more than one screen, show locations of each on sketch.