

E 2001

2-16-61

WATER WELL DRILLERS LOG

Hancock Co.?

Date: 2-16, 1961, Driller: Quirk & Grice County P.R.

(Name)

(1) Owner of Land: J V Lube (Name)

Santa Rosa Miss. (Address)

(2) Location: 1/4, 1/4, Sec. T. R.

9 miles South of Pine (distance, direction, Nearest Town)

(3) Topography: (Hilly) (Flat) (Level)

(4) Purpose of Well: Domestic (Domestic Irrigation, Municipal, Industrial, Other)

Description & Color of Materials Sand, Clay, Red Clay, Shell, etc.	Thick- ness Feet	Depth Feet
Clay	0	15
Sand gravel	15	100
Clay	100	210
Sand	210	320
Clay	320	415
Sand grad.	415	575
Clay Blue	575	700
Sand fine.	700	741

Information upon completion of well:

(1) Diameter: 2 inches.

(2) Total Depth: 741 feet.

(3) Water Level: Flow feet below top of ground.

(4) Cased to: Size

(5) Screen: Size 2", Length 20'

(6) Were any formations sealed against pollution?

yes, no.

If YES depth of formation


Why

Drillers Remarks: Not much well.

8 lbs Pressure.

30 gal Per

741

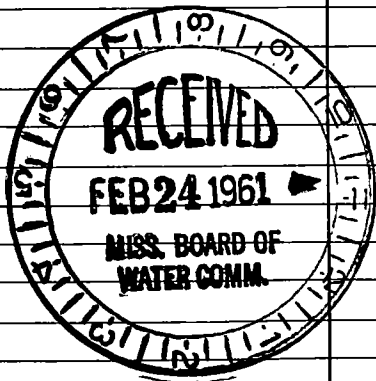

46

Well No.

(Use Back Side)

