

MISSISSIPPI BOARD OF WATER COMMISSIONERS

HANCOCK

E 7003 WATER WELL DRILLERS LOG

5-28-62

340

K-305

Date: 5-28, 1962, Driller: Sutter Well Wks. County Hancock

(Name)

	Description & Color of Materials Sand, Clay, Red Clay, Shell, etc.	Thick- ness Feet	Depth Feet
(1) Owner of Land: <u>Clarence Batey</u> (Name)	Clay	18	18
<u>Bay St. Louis, Miss.</u> (Address)	sand	27	45
(2) Location: <u>SW 1/4, SW 1/4, Sec. 17 T85R14W</u>	Clay	145	190
<u>10</u> miles <u>NW</u> of <u>Bay St. Louis</u> (distance) (direction) (Nearest Town)	sand	30	220
(3) Topography: <u>flat</u> (Hilly) (Flat) (Level)	Clay	170	390
(4) Purpose of Well: <u>domestic</u> (Domestic Irrigation Municipal, Industrial, Other)	sand	60	450
	Clay	55	505
	sand	40	545
	Clay	130	675
	sand	54	729


Information upon completion of well:

- (1) Diameter 2 inches.
- (2) Total Depth 729 feet.
- (3) Water Level 30 feet above below top of ground.
- (4) Cased to all, Size 2".
- (5) Screen: Size 2", Length 20'.
- (6) Were any formations sealed against pollution?
 yes, no.

If YES depth of formation _____

Why _____

Drillers Remarks: _____

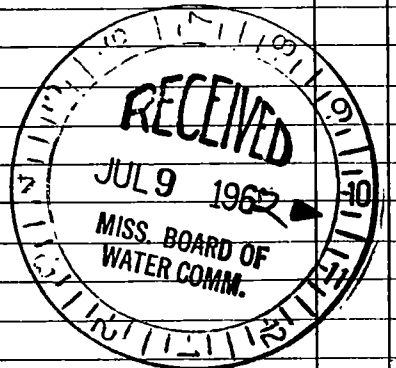

(Use Back Side)

Well No.

[The page contains extremely faint and illegible handwritten text, likely bleed-through from the reverse side. The text is scattered across the page and does not form any recognizable words or sentences.]