

HANCOCK MISSISSIPPI BOARD OF WATER COMMISSIONERS

E 2004  
6-8-62

WATER WELL DRILLERS LOG

F-301

Date: 6-8, 1962, Driller: J. Beck County Hancock  
(Name)

(1) Owner of Land:	Description & Color of Materials Sand, Clay, Red Clay, Shell, etc.	Thick- ness Feet	Depth Feet
<u>Hayward Fleming</u> (Name) <u>3024 Cabnet St. No La</u> (Address)	<u>Red mud + sand</u>	<u>90</u>	<u>90</u>
(2) Location: <u>SE 1/4, NW 1/4, Sec. 10 T7 R15</u>	<u>Hard Blue mud</u>	<u>71</u>	<u>161</u>
<u>10</u> miles <u>south</u> , of <u>Praying</u> (distance) (direction) (Nearest Town)	<u>strata</u>	<u>15</u>	<u>176</u>
(3) Topography: <input checked="" type="checkbox"/> (Hilly) <input type="checkbox"/> (Flat) <input type="checkbox"/> (Level)			
(4) Purpose of Well: <u>Home use</u> (Domestic Irrigation Municipal, Industrial, Other)	<u>Total</u>		<u>176'</u>

Information upon completion of well:


- (1) Diameter 2 1/4" inches.
- (2) Total Depth 176 feet.
- (3) Water Level 9 feet below top of ground.
- (4) Cased to \_\_\_\_\_, Size \_\_\_\_\_.
- (5) Screen: Size 1/4", Length 10'.
- (6) Were any formations sealed against pollution?  
\_\_\_\_\_ yes, \_\_\_\_\_ no.

If YES depth of formation \_\_\_\_\_

Why \_\_\_\_\_

Drillers Remarks: Back filled

with sand

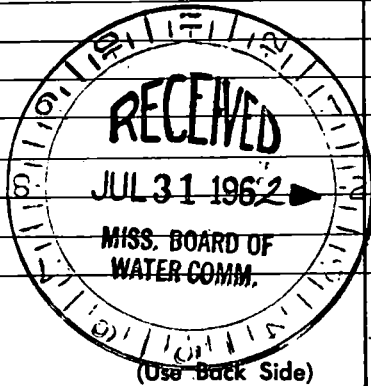

Well No.

