

E 2085
3-1-63

WATER WELL DRILLERS LOG

C

Date: 3-1, 1963, Driller: J. Beall County Hancock
(Name)

(1) Owner of Land: Lorin Meaine
(Name)
Rt 3 Box 245-A Ricoyune
(Address)
(2) Location: SE 1/4, SW 1/4, Sec. 13 T6RN
12 miles south of Ricoyune
(distance) (direction) (Nearest Town)
(3) Topography: (Hilly) (Flat) (Level)
(4) Purpose of Well: Home
(Domestic Irrigation
Municipal, Industrial, Other)


Description & Color of Materials Sand, Clay, Red Clay, Shell, etc.	Thick- ness Feet	Depth Feet
<u>White mud & sand</u>	<u>80</u>	<u>80</u>
<u>Blue mud</u>	<u>30</u>	<u>110</u>
<u>White sand</u>	<u>30</u>	<u>140</u>
<u>Blue mud hard</u>	<u>48</u>	<u>188</u>
<u>Strata</u>	<u>30</u>	<u>218</u>

Information upon completion of well:

(1) Diameter 2 1/4 inches.
(2) Total Depth 218 feet.
(3) Water Level 42 feet below top of ground.
(4) Cased to _____, Size _____
(5) Screen: Size 1 1/4, Length 20.
(6) Were any formations sealed against pollution?
_____ yes, _____ no.

If YES depth of formation _____
Why _____

Drillers Remarks:
Back filled with sand

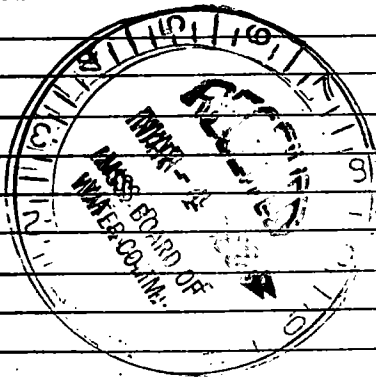

(Use Back Side)

Well No.

