

A Hancock
E 2008

MISSISSIPPI
 BOARD OF WATER COMMISSIONERS
 416 North State Street
 Jackson, Mississippi 39201

WATER WELL DRILLERS LOG

12-22-1978 Folsom Water Well Hancock
 date well completed firm name county well located

LANDOWNER: TERRY RAWIN
 PERKINSTON, MISS.

description of formations encountered	from	to
yellow clay		18
Very fine sand	18	22
Blue Clay	22	190
fine blue sand	190	218
Good sand	218	230
blue clay	230	—

(mailing address)

WELL LOCATION:
 sec. 18 T. 7 N. R. 16 E.
 (distance) (direction) (nearest town)

WELL PURPOSE: Home
 (home, irrigation, municipal, industrial)

WELL COMPLETION DATA:
 (1) diameter (inches) 2
 (2) total depth (feet) 230
 (3) static water level (feet) 40 below above top of ground.
 (4) casing PVC 220' (material) (depth)
 2" (size) If telescope see back.
 (5) screen 10' x .012 220' (length) (depth to top)
 2" Sch. 40 PVC (size) (material)
 (6) pump 1 7 (HP) (yield gpm)
 230V AC (type power)
 (7) electric log NO (yes or no)
 (organization running log)

(8) how well bottom plugged float type
 B.W.V.

DRILLERS REMARKS:

RECEIVED


JAN 3 1978

... OF WATER COMM

If well telescopes please sketch and show depths.

*This Well is located in
Bull Creek Park & White
Cypress Lakes Lot #47*

GROUND LEVEL

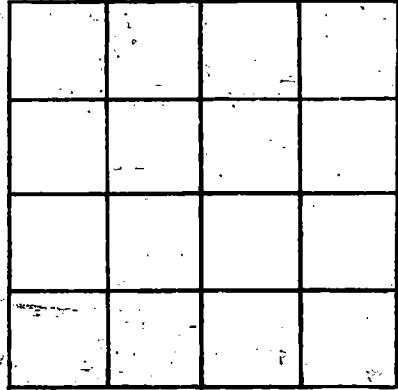

SECTION _____

Please indicate well location X.

ADDITIONAL INFORMATION

If more than one screen,
show locations of each on sketch.