

MISSISSIPPI DEPARTMENT OF NATURAL RESOURCES
Bureau of Land and Water Resources
 Southport Mall
 P.O. Box 10631
 Jackson, Mississippi 39209
WATER WELL DRILLERS LOG

Hancock
E 2013

9/10 1988 Bed Penton Hancock
 date well completed firm name county well located

LANDOWNER: Taylor
Box 403 South
 (mailing address)

description of formations encountered	from	to
<u>Red shale</u>	<u>0</u>	<u>21</u>
<u>White sand</u>	<u>21</u>	<u>65</u>
<u>Blue shale</u>	<u>65</u>	<u>740</u>
<u>Blue sand</u>	<u>740</u>	<u>818</u>

WELL LOCATION:
 sec. 30 T 7 N R 16 E
 S W
8 miles East of Prague
 (distance) (direction) (nearest town)

WELL PURPOSE: home
 (home, irrigation, municipal, industrial)

- WELL COMPLETION DATA:
- diameter (inches) 4"
 - total depth (feet) 818
 - static water level (feet) 25 below top of ground.
 - casing pvc, 818,
 (material) (depth)
4x2 if telescope see back.
 (size)
 - screen 15, 80.3
 (length) (depth to top)
12, pvc
 (size) (material)
 - pump 1 1/2, 1350
 (HP) (yield gpm)
Elect
 (type power)
 - electric log no
 (yes or no)
- (organization running log)
- (8) how well bottom plugged shale

RECEIVED


NOV 15 1988

Department of Natural Resources
 Bureau of Land & Water Resources

DRILLERS REMARKS:

If well telescopes please sketch and show depths.

GROUND LEVEL

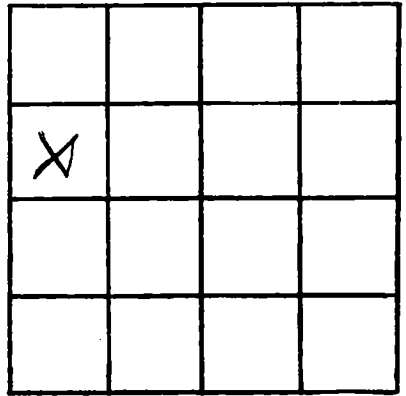

SECTION 30

Please indicate well location X.

ADDITIONAL INFORMATION

If more than one screen, show locations of each on sketch.