

MISSISSIPPI DEPARTMENT OF NATURAL RESOURCES
Bureau of Land and Water Resources
 Southport Mall
 P.O. Box 10631
 Jackson, Mississippi 39209
WATER WELL DRILLERS LOG

HANCOCK
E 2019

5/6 date well completed 19 *91* *Red Perton* firm name *Franklin* county well located

LANDOWNER: *Red Perton*
5100 x 3 South
 (mailing address)

WELL LOCATION:
 sec. *8* T. *8* N R. *16* E
12 miles *East* of *Proctor*
 (distance) (direction) (nearest town)

WELL PURPOSE: *home*
 (home, irrigation, municipal, industrial)

WELL COMPLETION DATA:

(1) diameter (inches) *2 1/2*

(2) total depth (feet) *570*

(3) static water level (feet) *82* below above top of ground.

(4) casing *PVC* *700*
 (material) (depth)
 (size) If telescope see back.

(5) screen *10* *690*
 (length) (depth to top)
12 *PVC*
 (size) (material)

(6) pump *no*
 (HP) (yield gpm)
 (type power)

(7) electric log *no*
 (yes or no)
 (organization running log)

(8) how well bottom plugged *shale sand*

description of formations encountered	from	to
<i>Red shale</i>	<i>0</i>	<i>15</i>
<i>White sand</i>	<i>15</i>	<i>50</i>
<i>Blue shale</i>	<i>50</i>	<i>455</i>
<i>Blue sand</i>	<i>455</i>	<i>480</i>
<i>Blue shale</i>	<i>480</i>	<i>500</i>
<i>sand no gravel</i>	<i>500</i>	<i>520</i>
<i>Blue shale</i>	<i>520</i>	<i>640</i>
<i>Gray sand</i>	<i>640</i>	<i>700</i>

RECEIVED


JUN 7 1991

Dept. of Environmental Quality
 Bureau of Land & Water Resources

DRILLERS REMARKS:

If well telescopes please sketch and show depths.

GROUND LEVEL

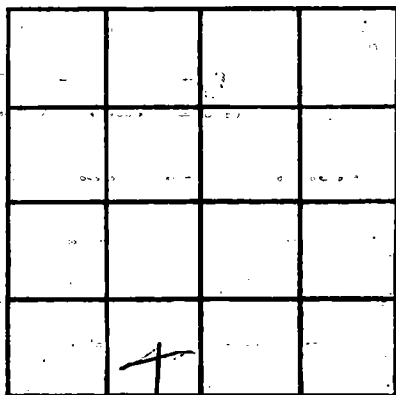

SECTION _____

Please indicate well location X.

ADDITIONAL INFORMATION

If more than one screen, show locations of each on sketch.