

CODED

WATER WELL DRILLERS LOG

Date: 7-24, 1961, Driller: Sutter Well Works County Hancock


(Name)

(1) Owner of Land: Davis Jouchet
 (Name)
823-8th St. N.O. La.
 (Address)
 (2) Location: 3715
 1/4, 1/4, Sec. T R
Bay St
10 miles W (direction) Port of Louis (Nearest Town)
 (3) Topography: flat
 (Hilly) (Flat) (Level)
 (4) Purpose of Well: domestic
 (Domestic Irrigation
 Municipal, Industrial, Other)

Description & Color of Materials Sand, Clay, Red Clay, Shell, etc.	Thick- ness Feet	Depth Feet
<u>Clay</u>	<u>18</u>	<u>18</u>
<u>sand</u>	<u>22</u>	<u>40</u>
<u>Clay</u>	<u>45</u>	<u>85</u>
<u>sand</u>	<u>14</u>	<u>99</u>

Information upon completion of well:

(1) Diameter 1 1/4 inches.
 (2) Total Depth 99 feet.
 (3) Water level 11 feet below top of ground.
 (4) Cased to all, Size 1 1/4"
 (5) Screen: Size 1 1/4", Length 5
 (6) Were any formations sealed against pollution?
 _____ yes, no.

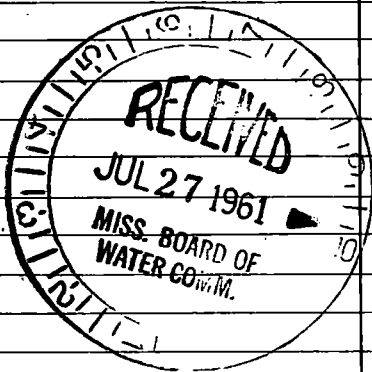

CODED

If YES depth of formation _____
 Why _____
 Drillers Remarks: _____

(Use Back Side)

Well No.

